

REPORT ~~OF~~ COMPLETED WORKS - SEACOAST FOR
(Battery Plan)






Corrected to SEPT. 1-21.

FORM NO. 7

COAST DEFENSES OF NARRAGANSETT BAY
FORT KEARNY, R.I.

BATTERY ARMISTEAD

No. of Guns - 2 Caliber - 3in. Carriage Barb. R. 4

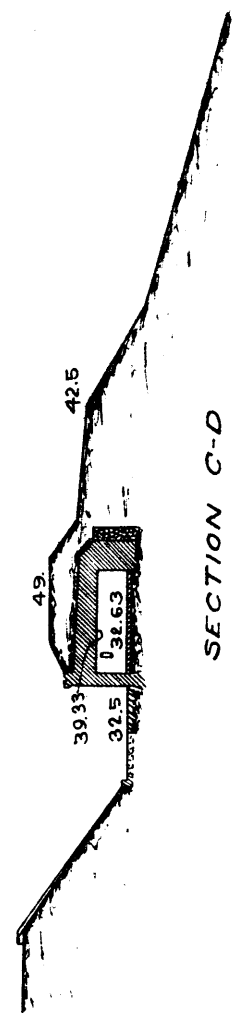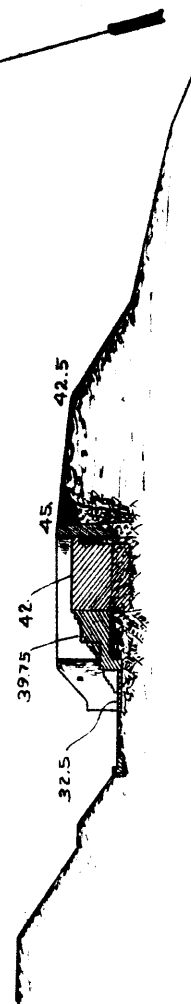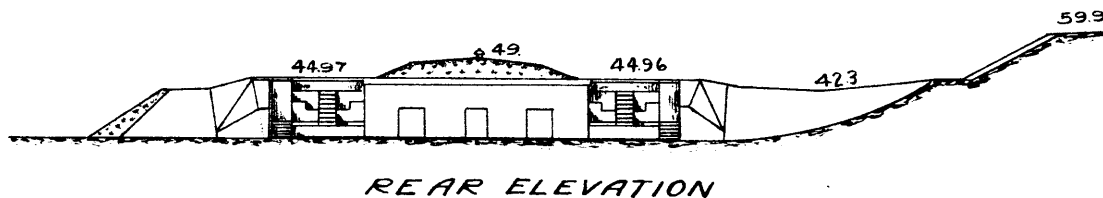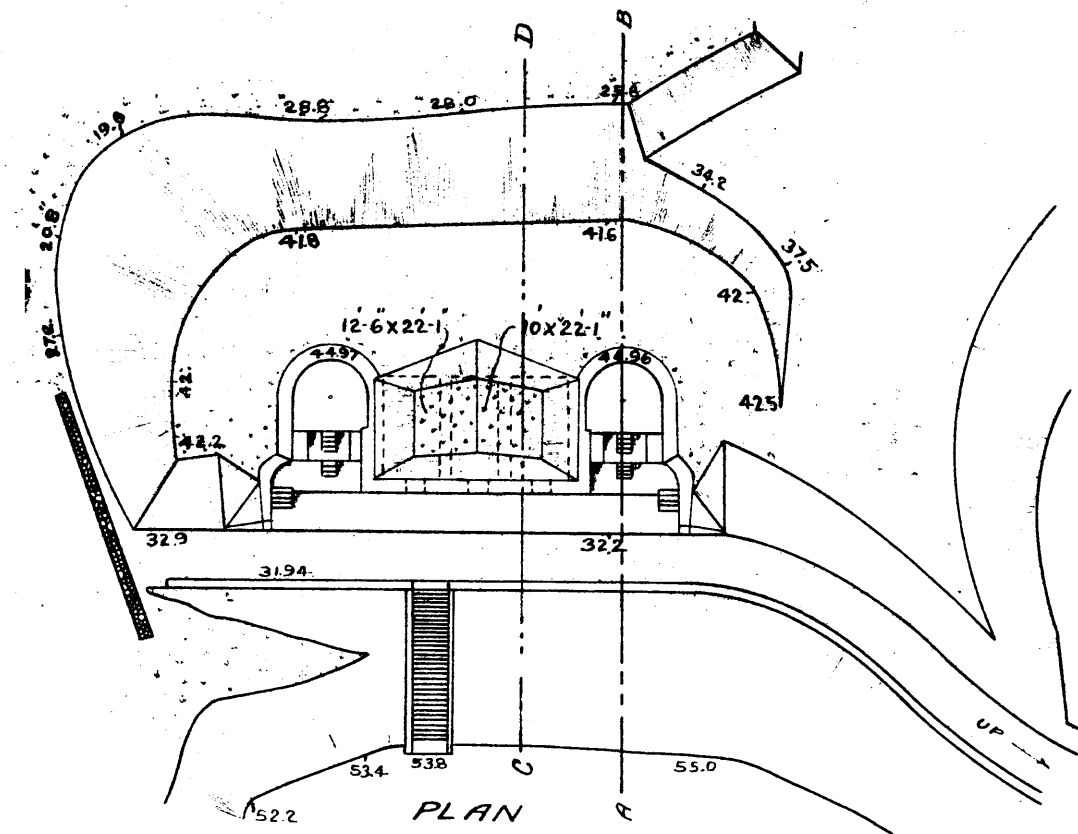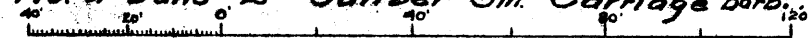

REPORT OF COMPLETED WORKS SEACOAST FORTS
(Battery Plan)

Corrected to SEPT 1-21.


COAST DEFENSES OF NARRAGANSETT BAY
FORT ADAMS, R.I.

BATTERY BANKHEAD

No. of Guns 3 Caliber 6 in Carriage Fed (Armstrong)

FORM NO. 7

40' 20' 0' 40' 80' 120'

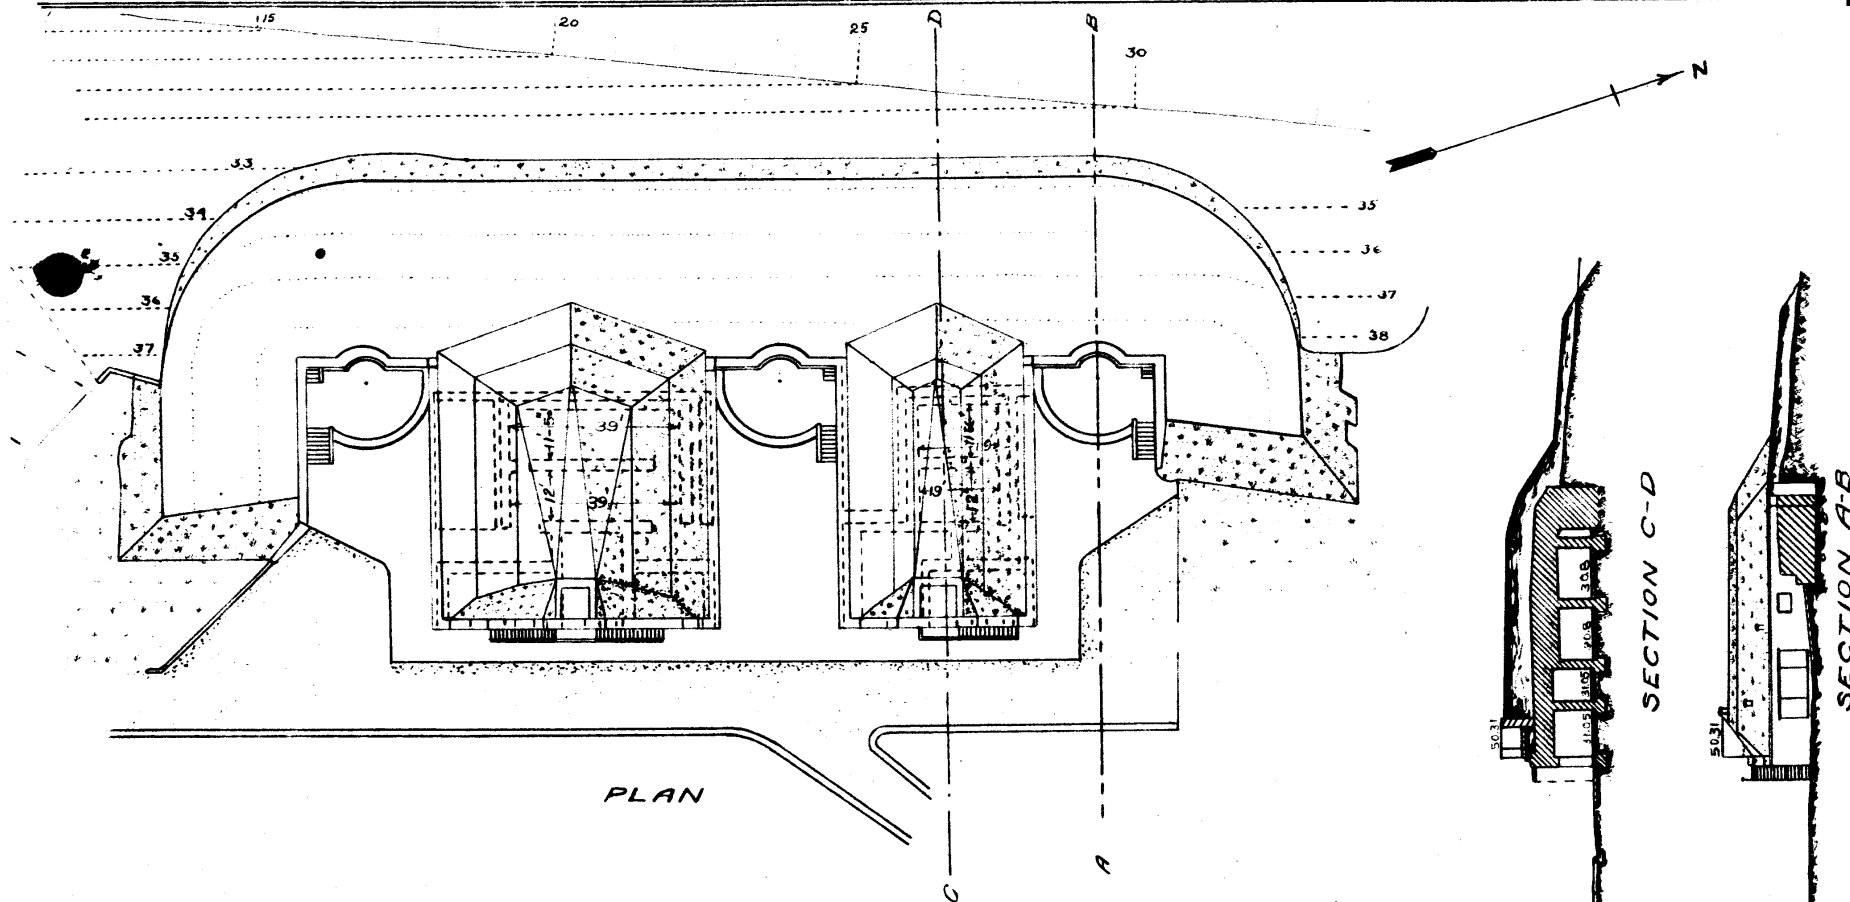

PLAN

SECTION C-D

SECTION A-B

REAR ELEVATION

REPORT OF COMPLETED WORKS - SEACOAST FORTS
(Battery Plan)





Corrected to SEPT. 1-21.

FORM NO 7.

COAST DEFENSES OF NARRAGANSETT BAY
FORT ADAMS R.I.
BATTERY BELTON

No. of Guns - 2 Caliber - 3in. Carriage Barb.

40' 20' 0' 40' 80' 120'

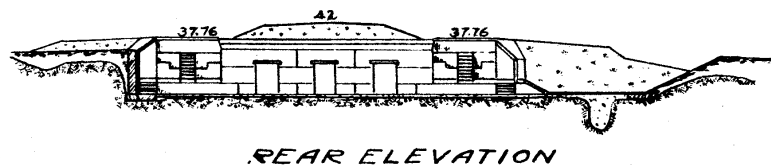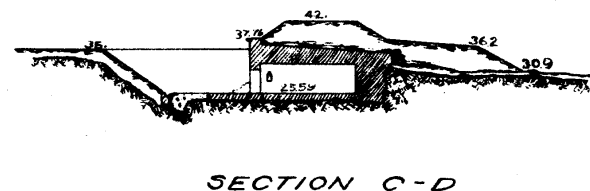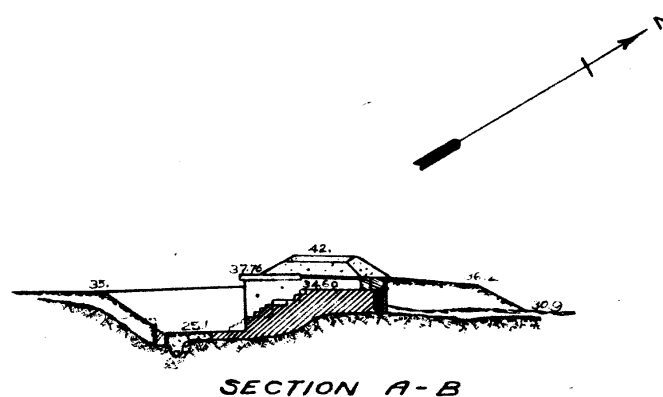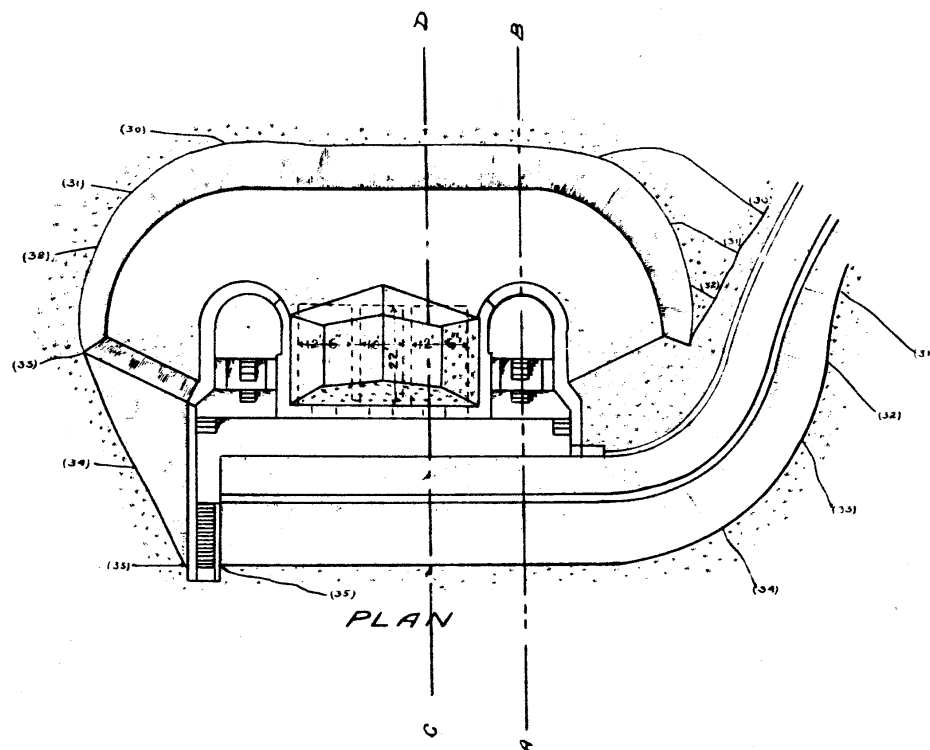




REPORT COMPLETED WORKS - SEACOAST FOR
(Battery Plan)

Corrected to SEPT. 1-21.


FORM NO. 7

COAST DEFENSES OF NARRAGANSETT BAY
FORT WETHERILL, R.I.
BATTERY COOKE


No. of Guns - 2 Caliber - 3 in. Carriage Pad. Mt.

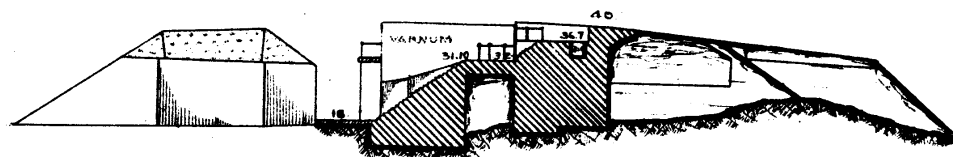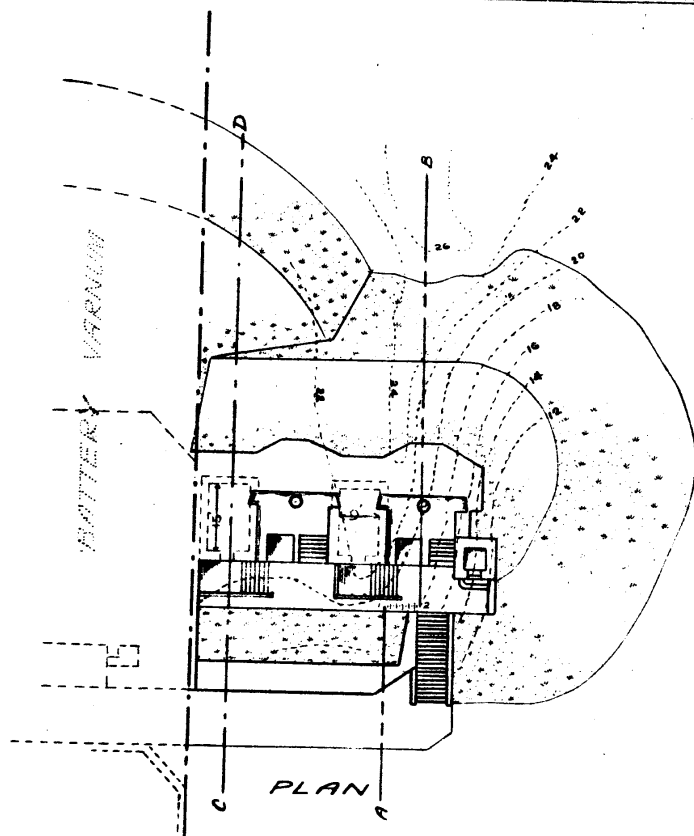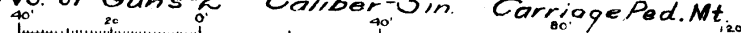

SECTION A-B

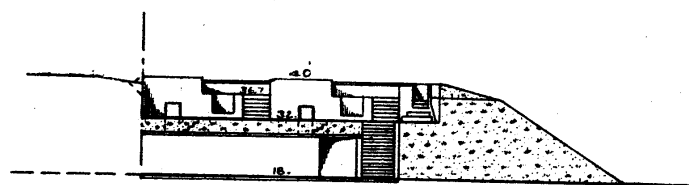

REAR ELEVATION

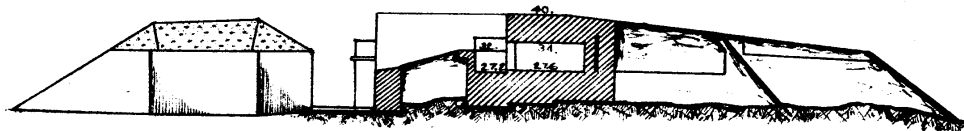

SECTION C-D






REPORT OF COMPLETED WORKS - SEACOAST FORTS
(Battery Plan)

Corrected to SEPT. 1-21.

FORM NO. 7

COAST DEFENSES OF NARRAGANSETT BAY
FORT KEARNY, R.I.
BATTERY CRAM

No. of Guns-2 Caliber-6in. Carriage-Dis. L.F.

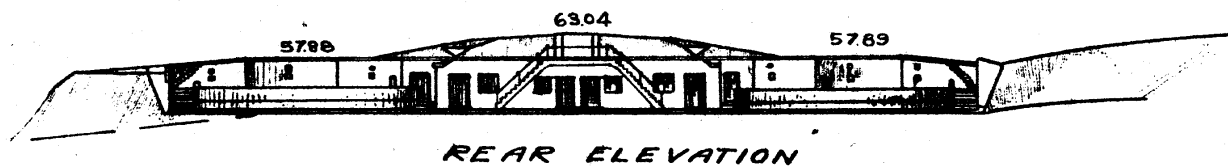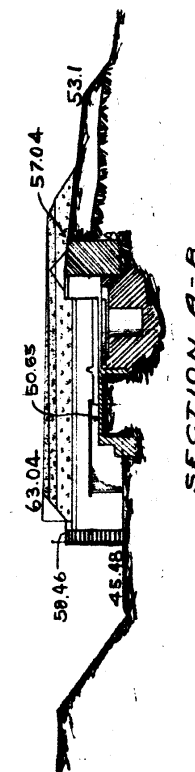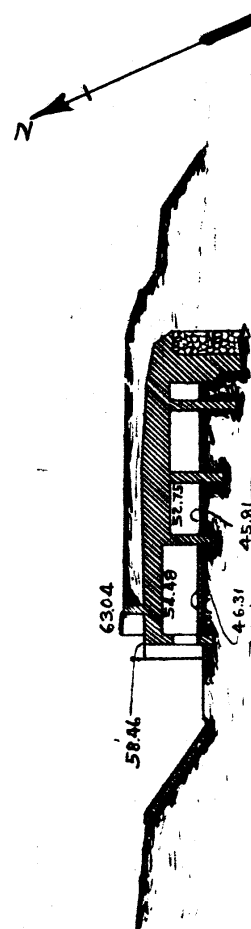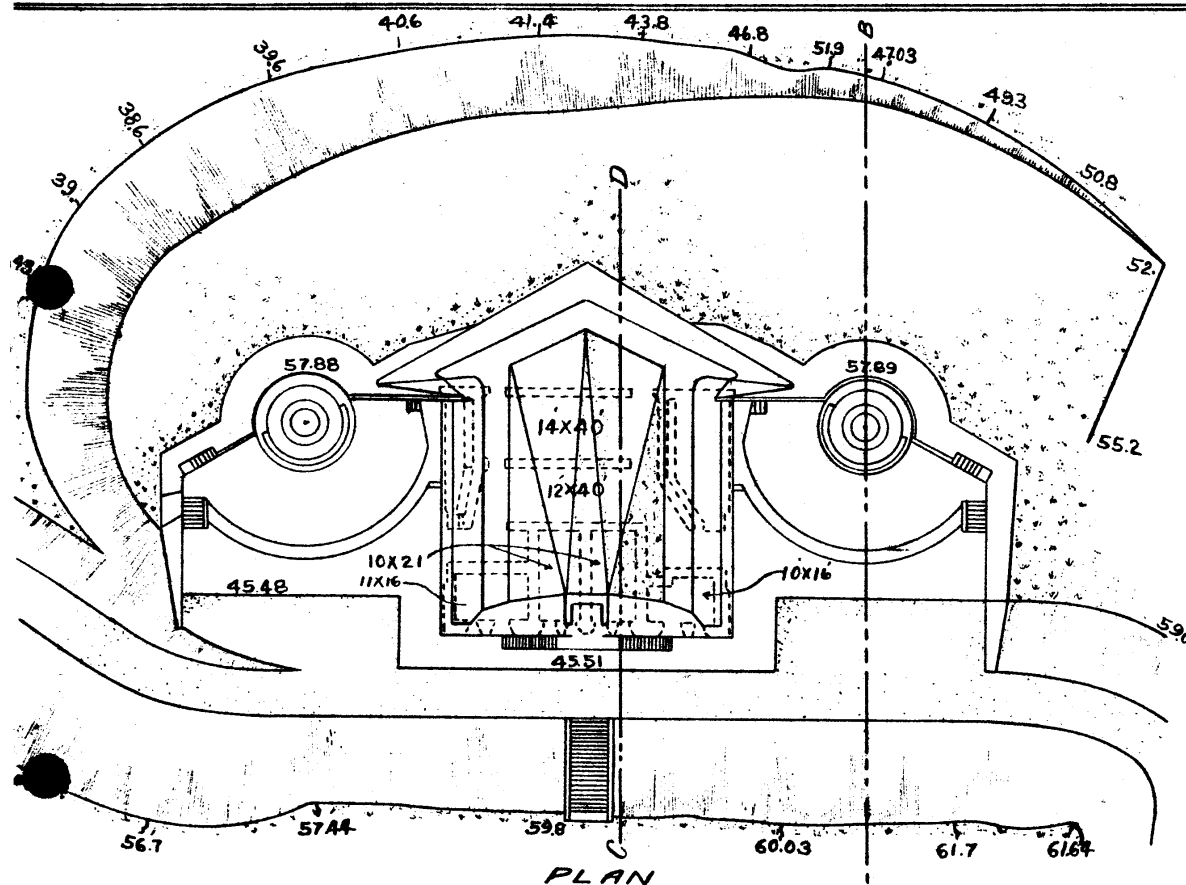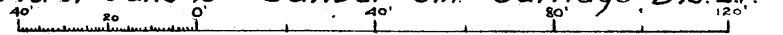

REPORT COMPLETED WORKS

(Battery Plan)

Corrected to Dec 1, 1925



FORM NO. 7

HARBOR DEFENSES OF NARRAGANSETT BAY


FORT WETHERILL, R.I.

BATTERY CRITTENDEN


No. of Guns 2 Caliber 3in. Carriage Barb.

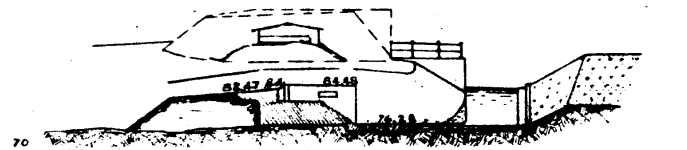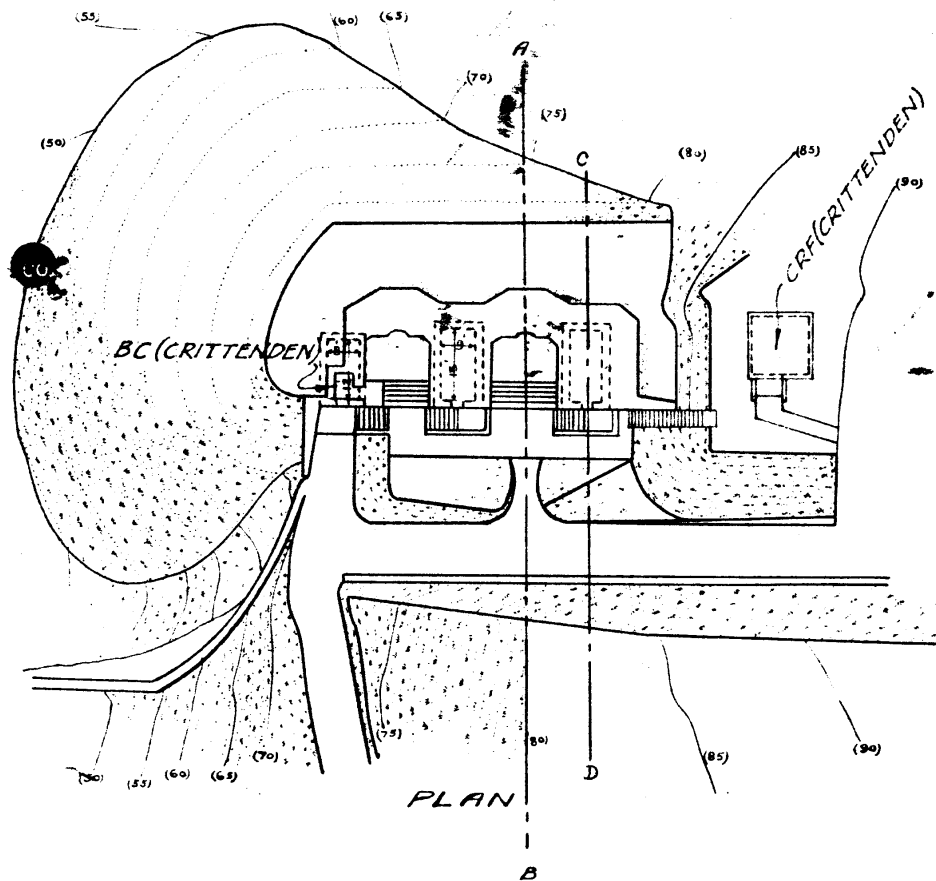

SECTION A-B

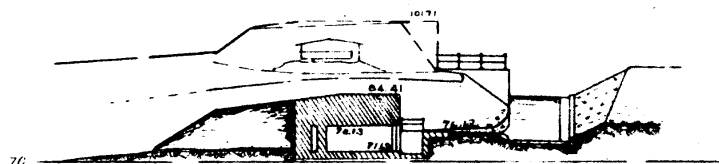

SECTION C-D

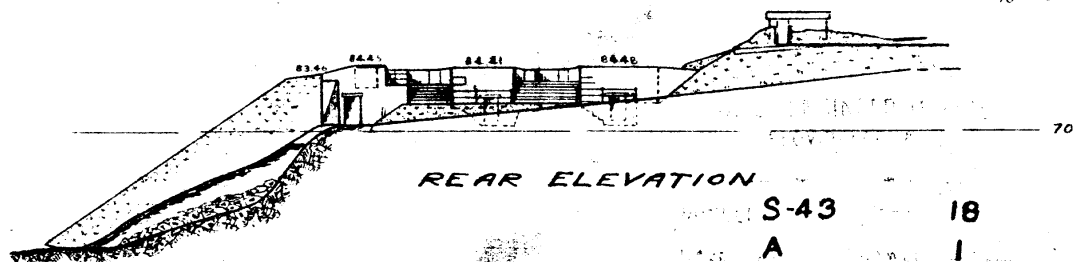

REAR ELEVATION

S-43 18
A 1

REPORT COMPLETED WORKS -

(Battery Plan)

Corrected to Dec. 1, 1925

FORM NO. 7





HARBOR DEFENSES OF NARRAGANSETT BAY

FORT WETHERILL, R.I.

BATTERY DICKENSON

No. of Guns - 2 Caliber - 6 in. Carriage Barb.

40' 20' 0' 40' 80' 120'

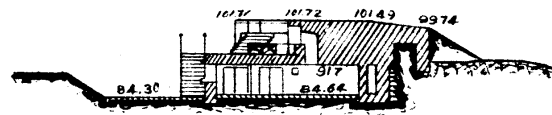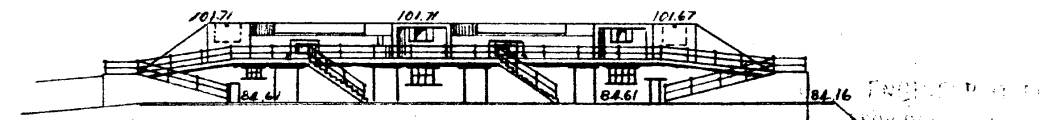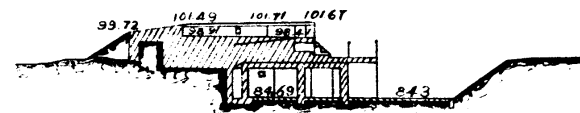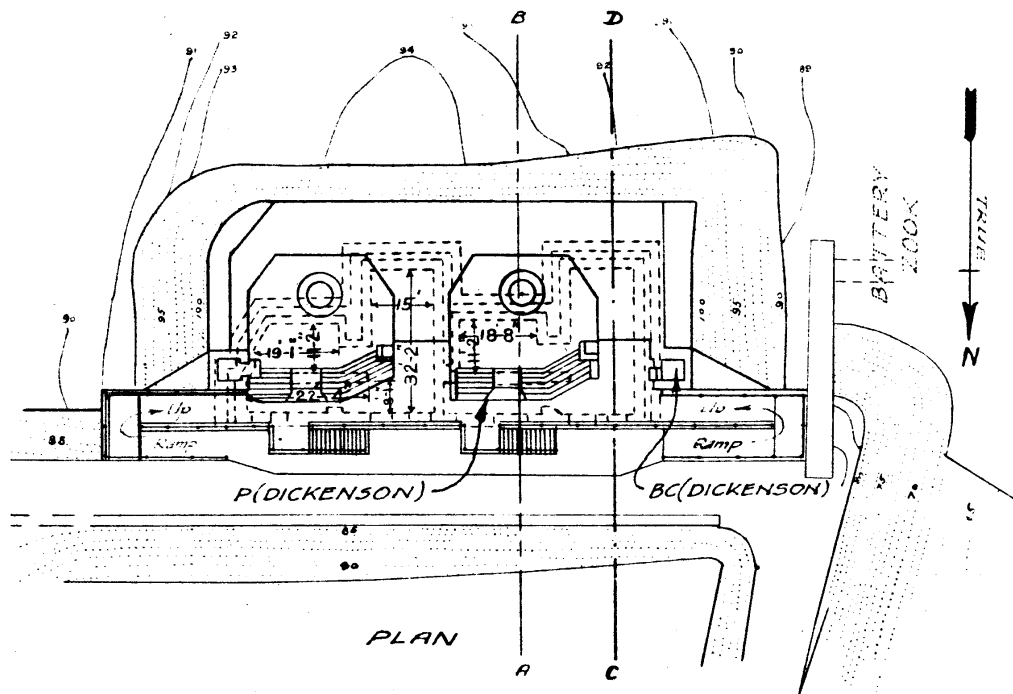

S-43 19

A 1

REPORT OF COMPLETED WORKS
(Battery Plan)



Corrected to Dec. 1, 1925

FORM NO. 7


HARBOR DEFENSES OF NARRAGANSETT BAY
FORT KEARNY, R.I.
BATTERY FRENCH

No of Guns-4 Caliber-6 in. Carriage-Dis. L.F.

40' 20' 0' 40' 80' 120'

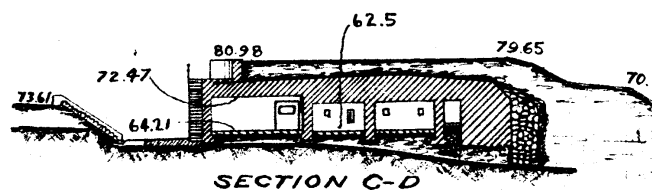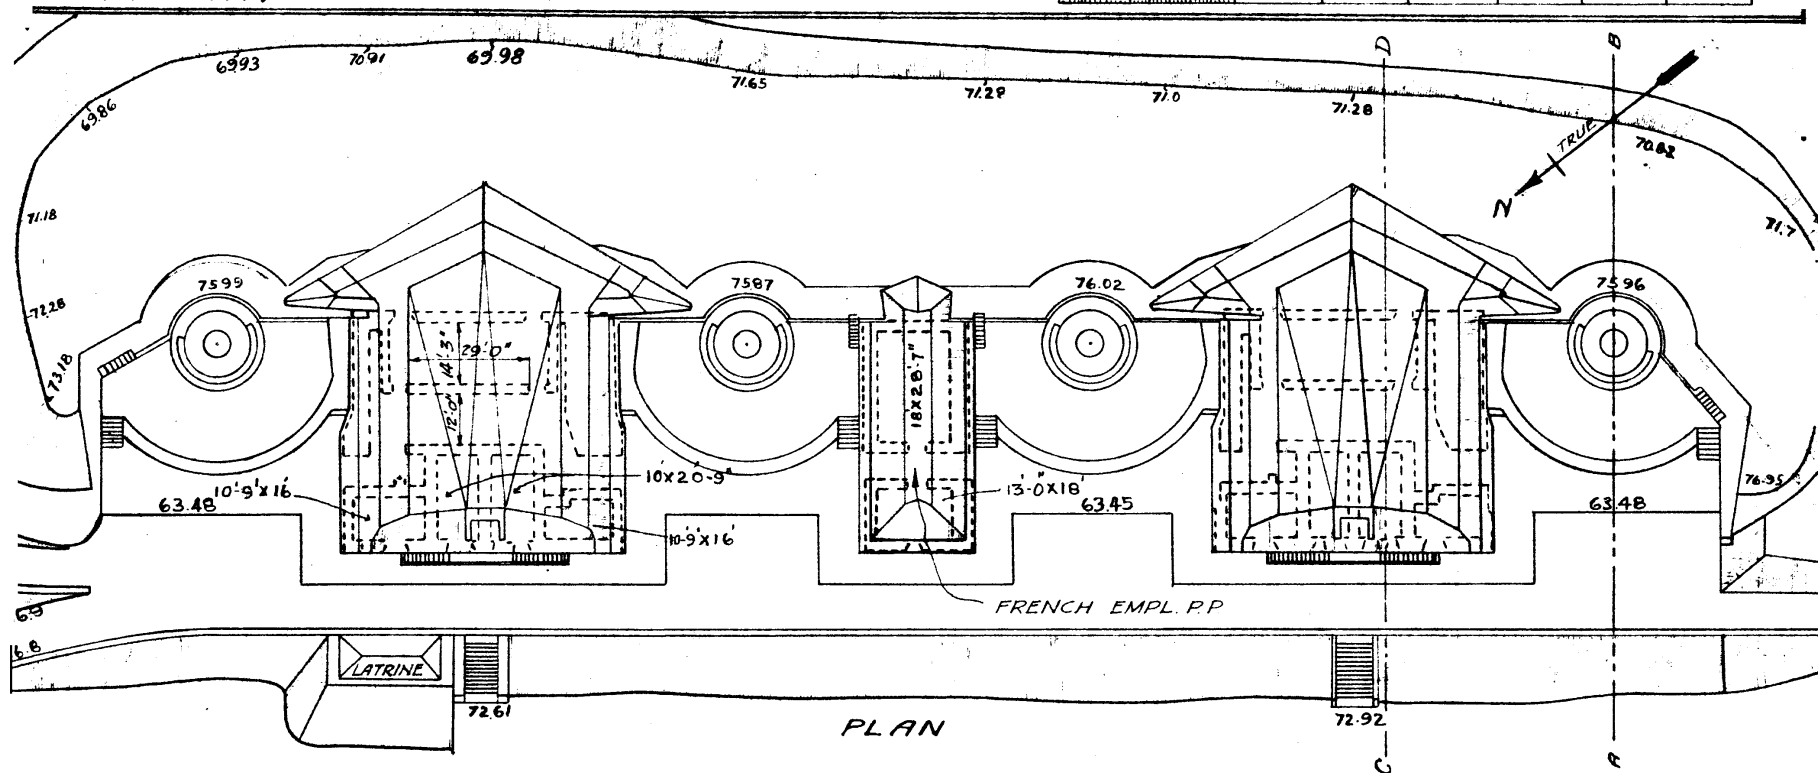

ENGINEER OFFICE
PROVIDENCE
S-43 23
A I

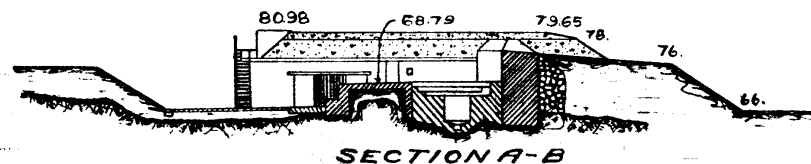

REPORT OF COMPLETED WORKS

(Battery Plan)

Corrected to Dec. 1, 1925


FORM NO. 7

HARBOR DEFENSES OF NARRAGANSETT BAY

FORT ADAMS, R.I.

BATTERY GREENE & BATTERY EDGERTON

No. of Guns - 8 Caliber - 12 in. Carriage - Mor.

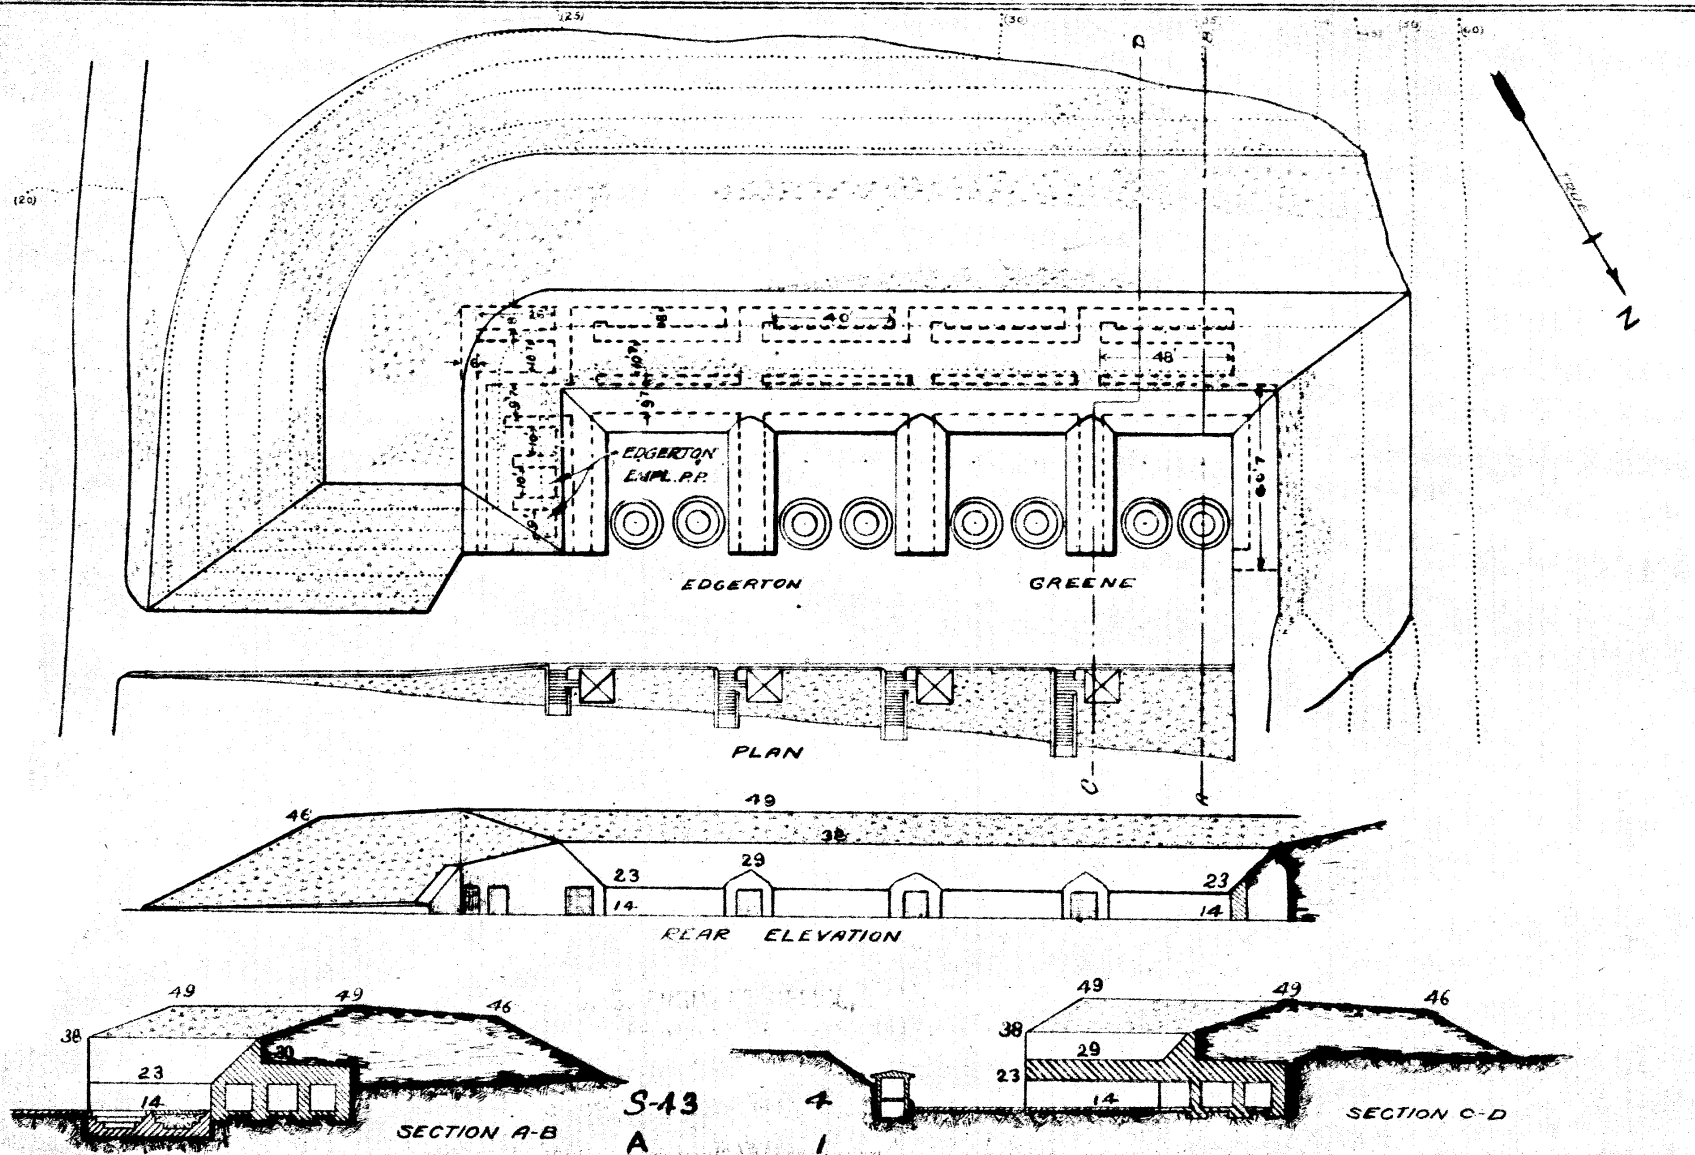


Corrected to Dec. 1, 1925

HARBOR DEFENSES OF NARRAGANSETT BAY
FORT GREBLE, R.I.
BATTERY HALE

No. of Guns-3 Caliber-10in. Carriage-Dis.




 NOTE:- Elev referenced to Local Datum
which is 1.31' below M.L.W.



S-43
A

 
9



Corrected to Dec. 11/25

HARBOR DEFENSES OF NARRAGANSETT BAY
FORT GETTY, R.I.
BATTERY HOUSE

No. of Guns-2 Caliber-6in Carriage-Barb.

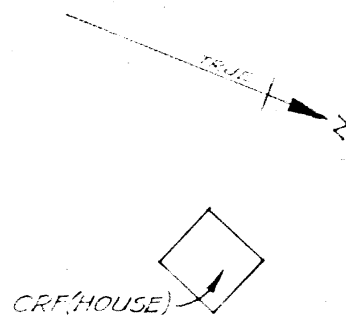

SECTION C D

SECTION A B

S-43
A

14
1

NOTE:- Elev. referenced to Local Datum
which is 121' below M.L.W.

REPORT OF COMPLETED WORKS

(Battery Plan)

Corrected to Dec. 1, 1925


FORM NO. 7


HARBOR DEFENSES OF NARRAGANSETT BAY

FORT GREBLE, R.I.

BATTERY MITCHELL

No. of Guns-3 Caliber-6 in. Carriage-Dis.

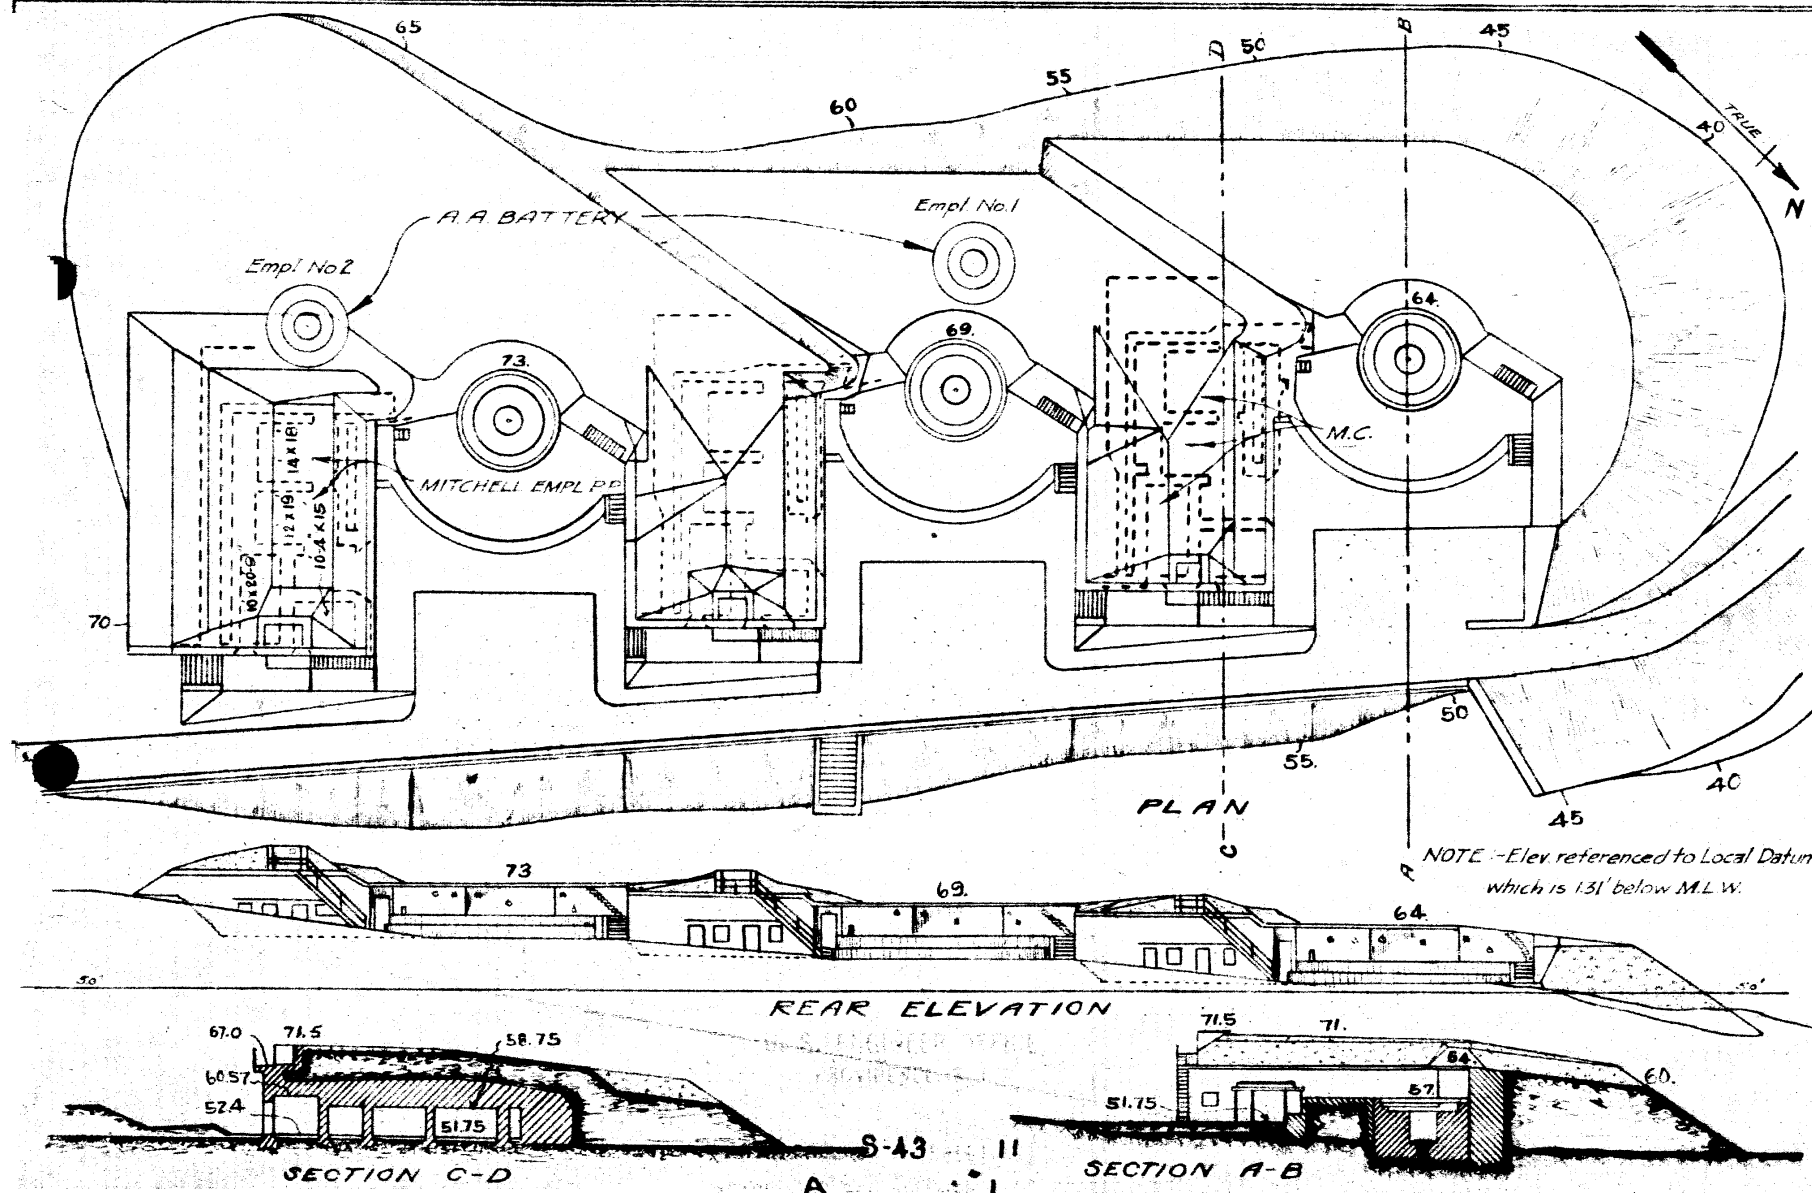

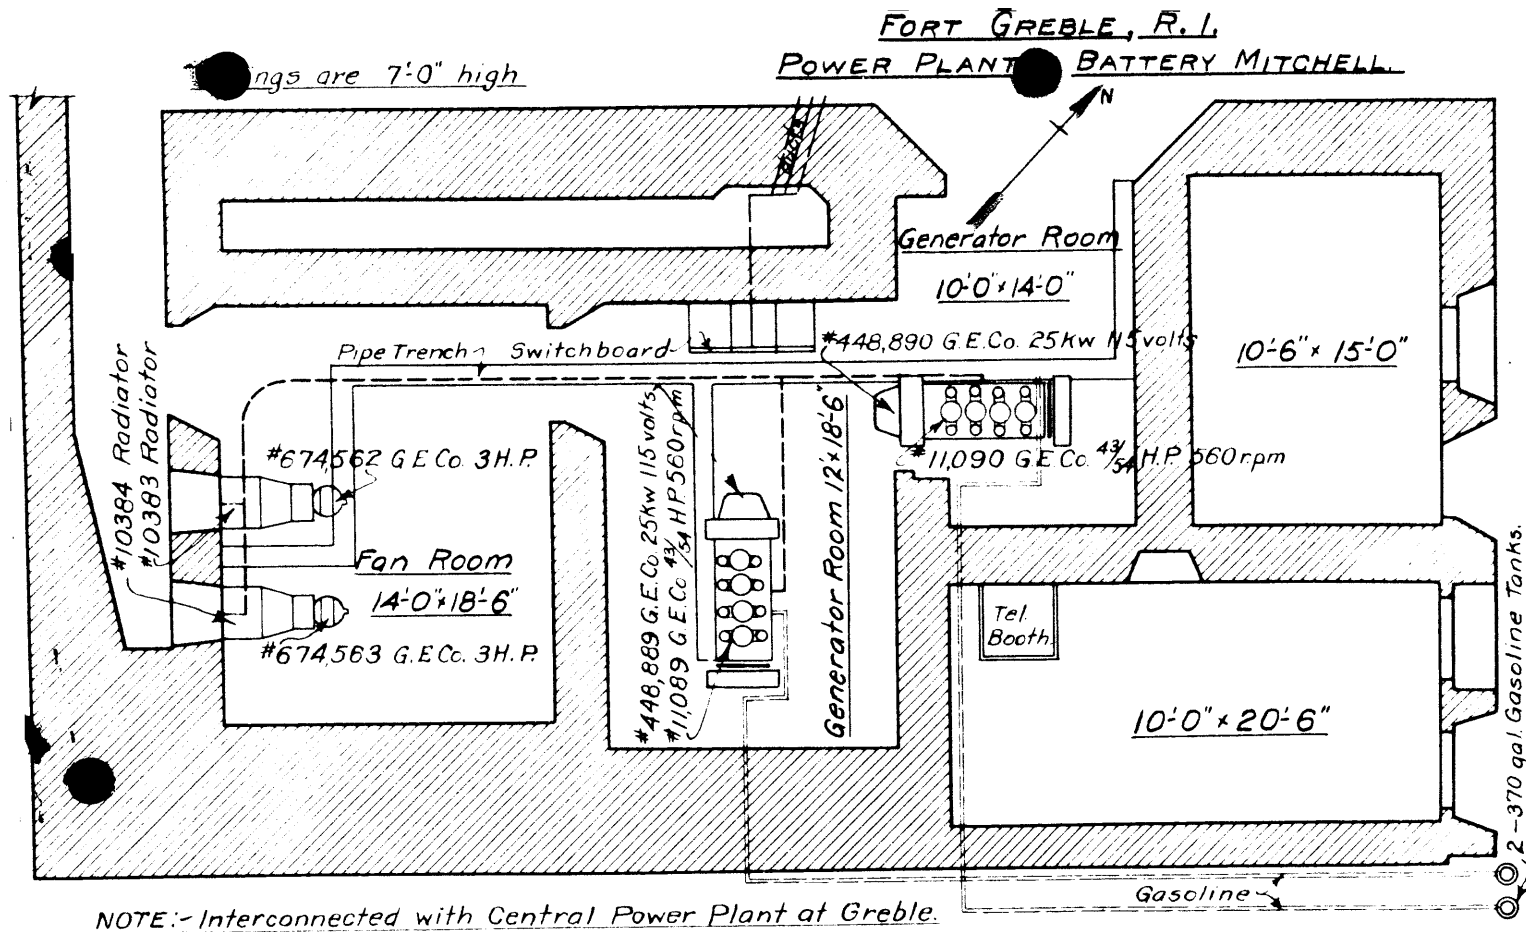

REPORT OF COMPLETED WORKS

(Battery Plan)

Corrected to Dec. 1, 1925

FORM NO. 7

HARBOR DEFENSES OF NARRAGANSETT BAY



FORT GREBLE, R.I.

BATTERY OGDEN


No. of Guns - 2

Caliber - 3 in.


Carriage Ped Mt.

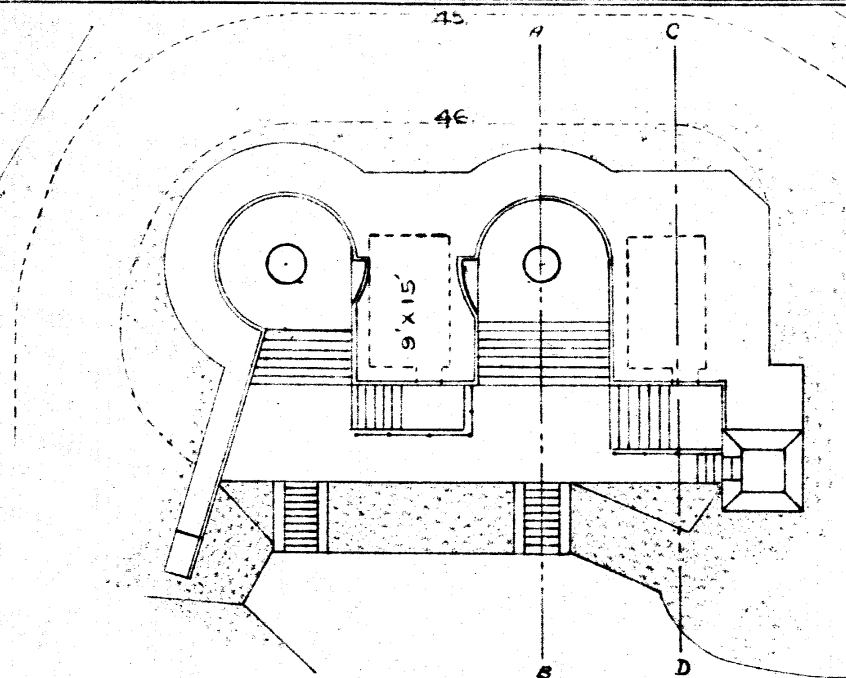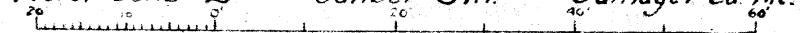


PLAN

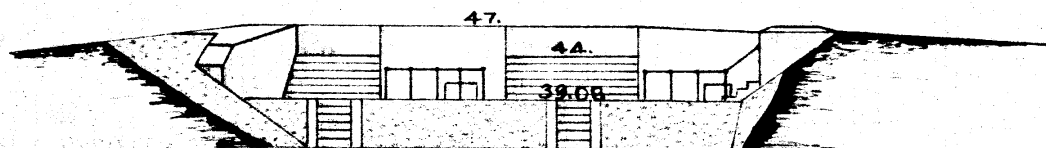

REAR ELEVATION

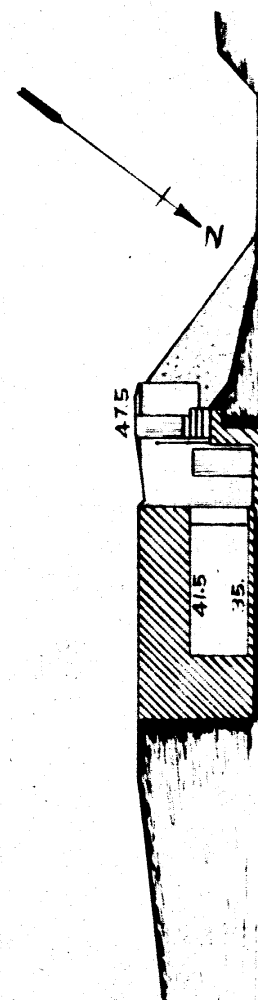

SECTION C-D

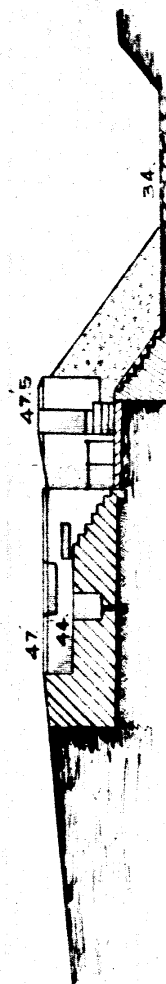

SECTION A-B

S-43

8

A

1

NOTE: Elev. referenced to Local Datum which is 1.31' below M.L.W.

REPORT OF COMPLETED WORKS - SEACOAST FORTS
 (Battery Plan)
 Corrected to SEPT. 21.





COAST DEFENSES OF NARRAGANSETT BAY
 FORT ADAMS E.I.
 BATTERY REILLY

No. of Guns - 2

Caliber - 10 in. Carriage - Dis.

FORM NO. 7

40' 20' 0' 40' 80' 120'

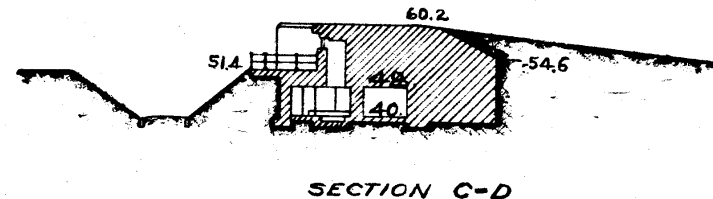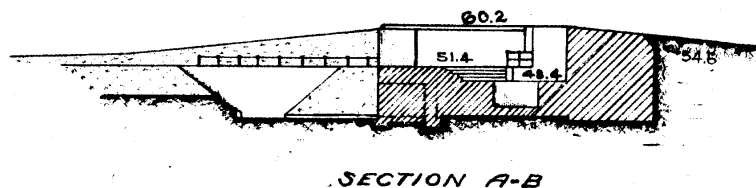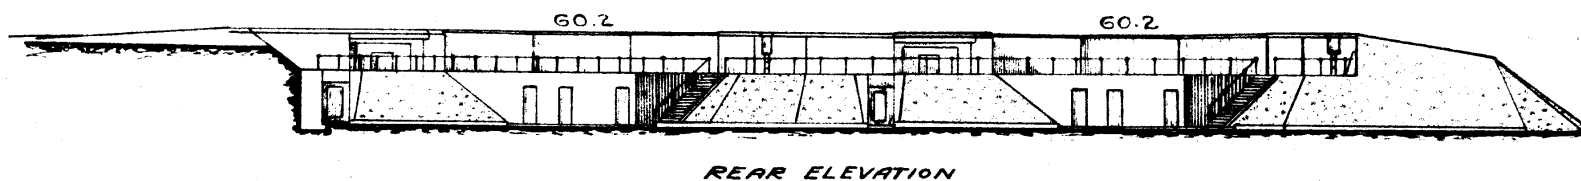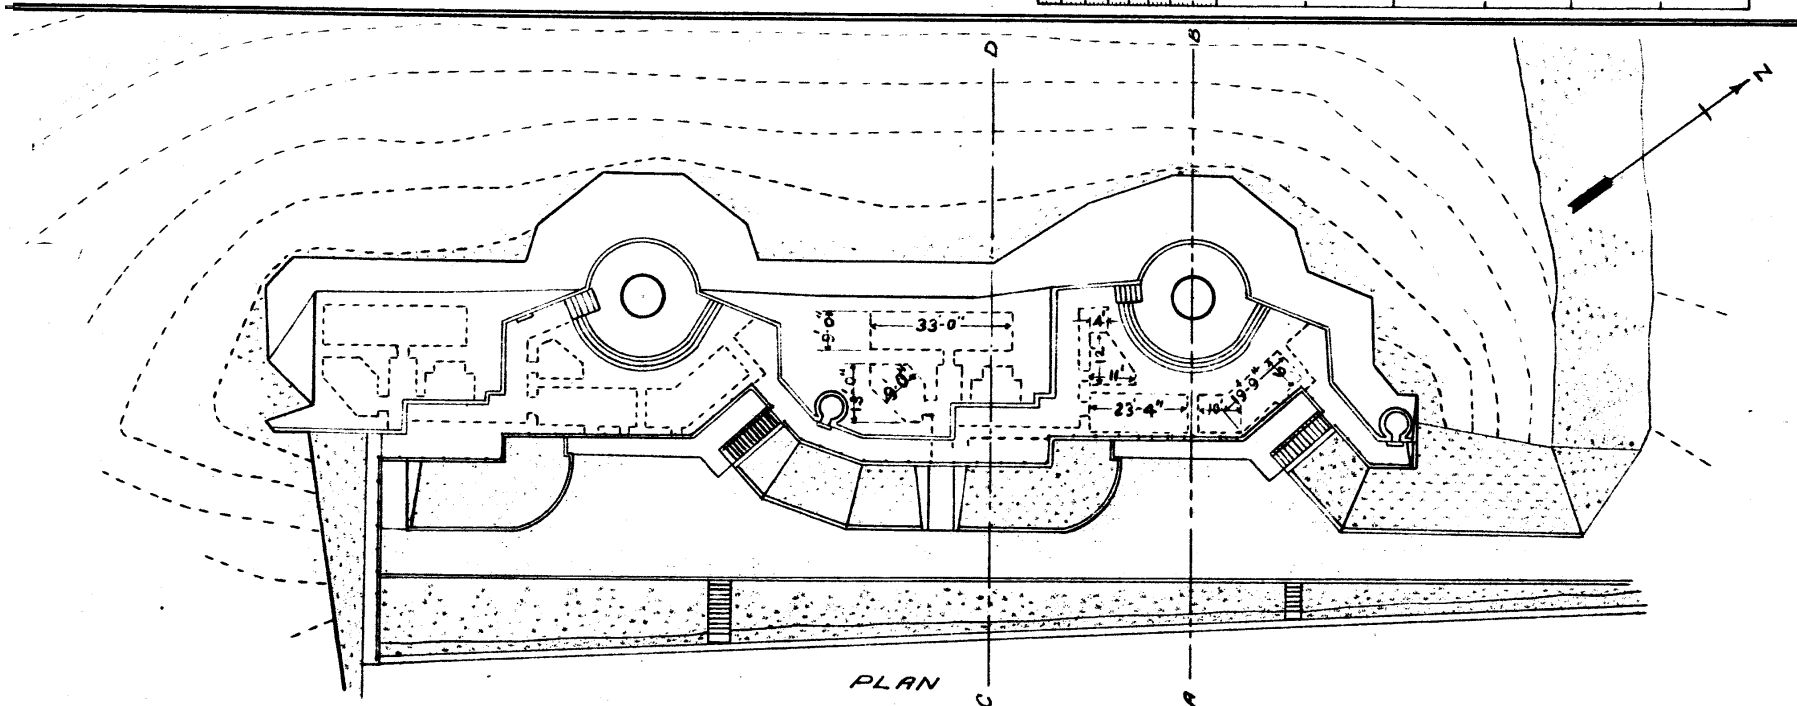

REPORT OF COMPLETED WORKS

(Battery Plan)

Corrected to Dec. 1, 1925





 
FORM NO. 7.

HARBOR DEFENSES OF NARRAGANSETT BAY

FORT GREBLE, R.I.

BATTERY SEDGWICK

No. of Guns-4 Caliber-12" Carriage-Mor

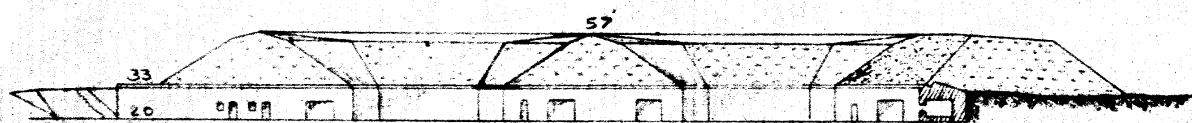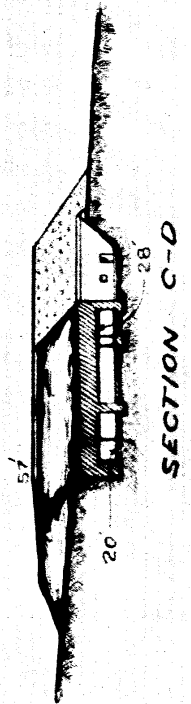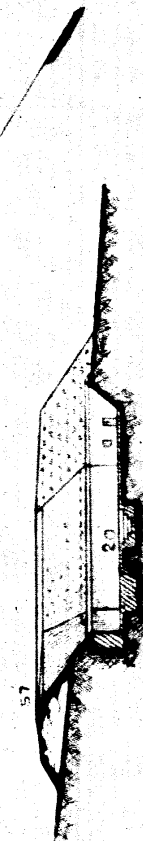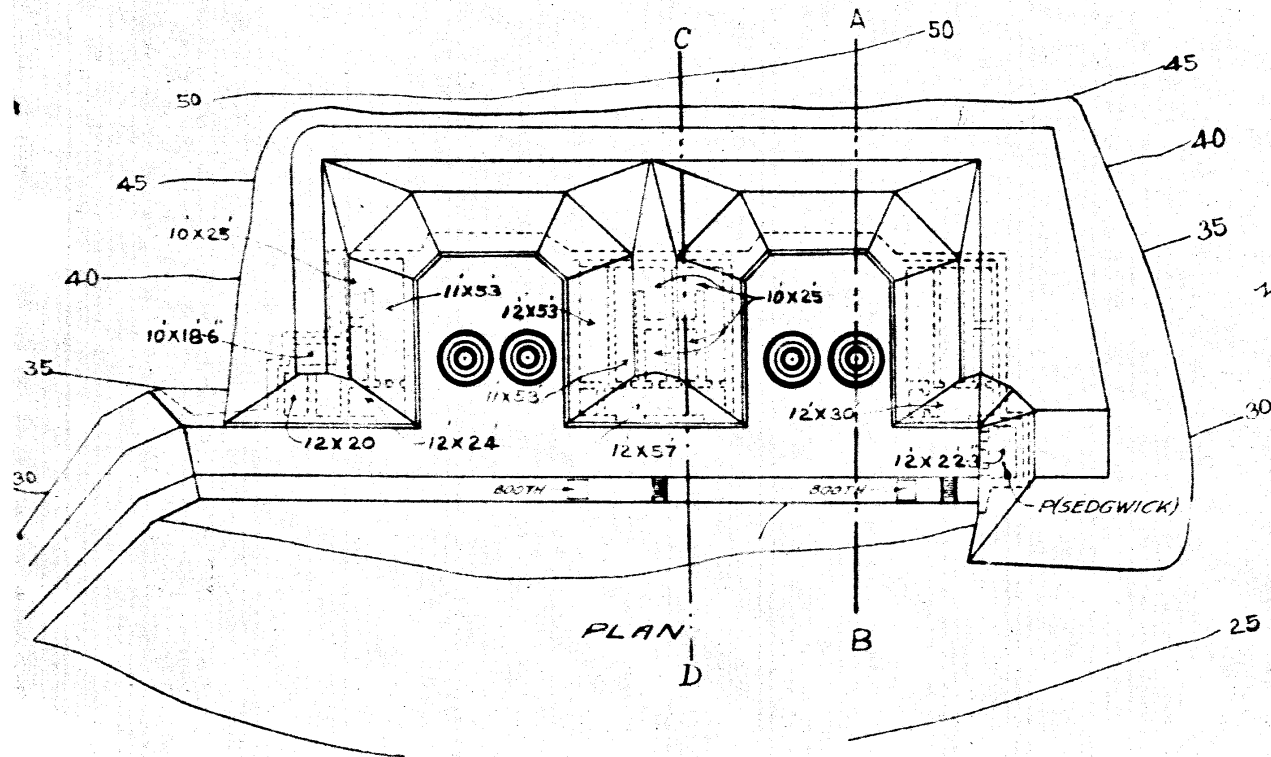

S-43

10

A

I

NOTE: -Elev. referenced to Local Datum which is 1.31' below M.L.W.



REPORT OF COMPLETED WORKS - SEACOAST FORTS
(Battery Plan)

Corrected to SEPT. 1-21.


FORM NO. 7

COAST DEFENSES OF NARRAGANSETT BAY.
FORT ADAMS, R.I.
BATTERY TALBOT


No of Guns - 2 Caliber - 4.72 in. Carriage (Ped.) (Armstrong)

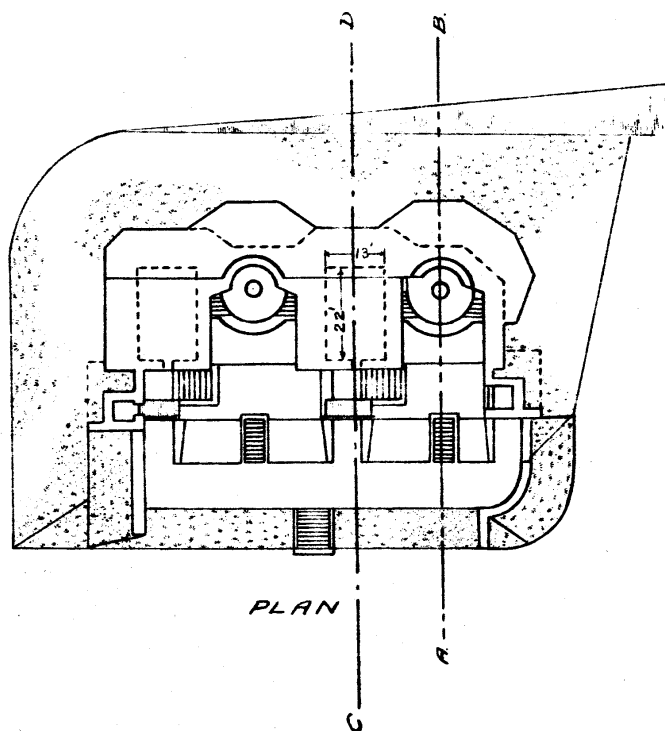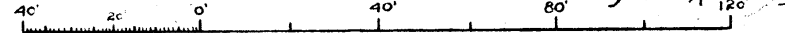

REAR ELEVATION

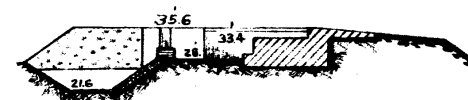

SECTION A-B

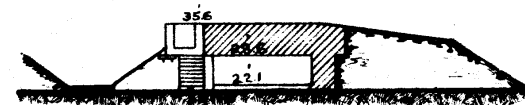

SECTION C-D



REPORT OF COMPLETED WORKS

(Battery Plan)

Corrected to Dec. 1, 1925

FORM NO 7



HARBOR DEFENSES OF NARRAGANSETT BAY.

FORT GETTY R.I.


BATTERY TOUSARD

No of Guns - 3 Caliber - 12 in. Carriage Dis.

0 10 20 1000

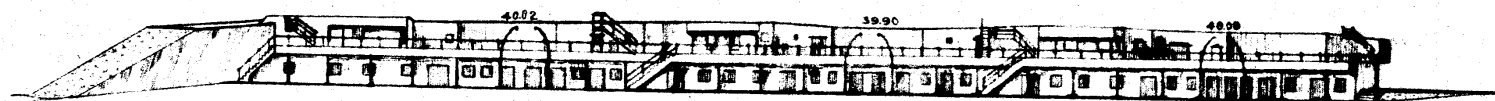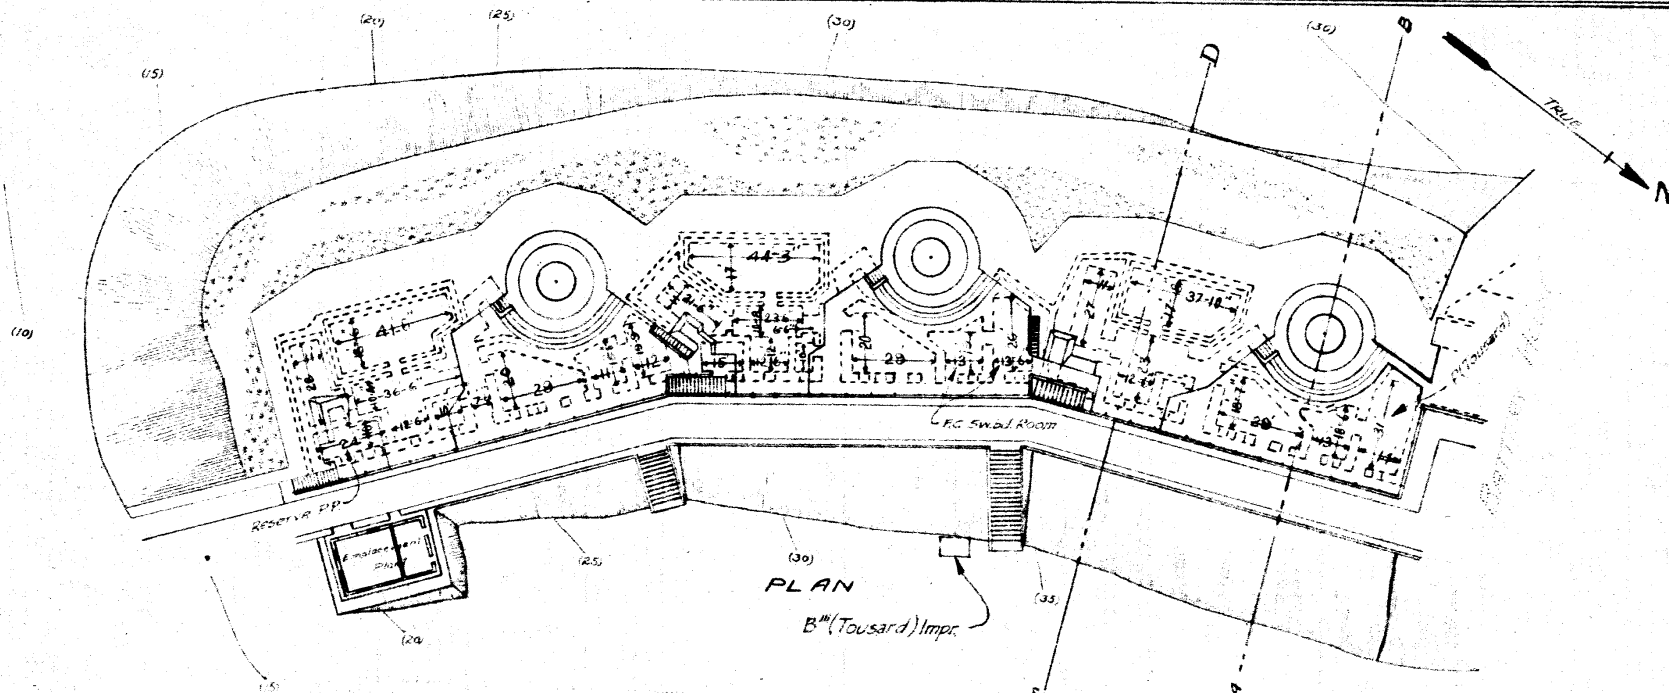

REAR ELEVATION

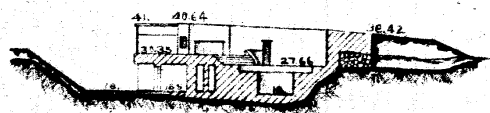

SECTION A-B

S-43

12

A

I



SECTION C-D

NOTE: Elev. referenced to Local Datum which is 1.21' below M.L.W.

REPORT ~~COMPLETED~~ WORKS

(Battery Plan)

Corrected to Dec. 1, 1925




FORM NO 7

HARBOR DEFENSES OF NARRAGANSETT BAY


FORT WETHERILL, R.I.

BATTERY VARNUM


No. of Guns - 2 Caliber - 12in Carriage - Barb.

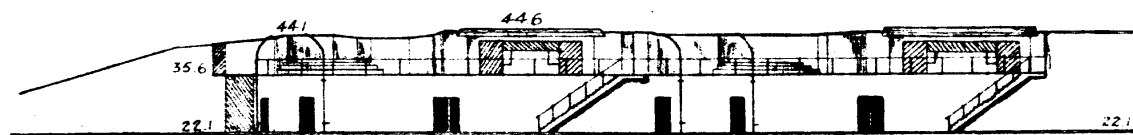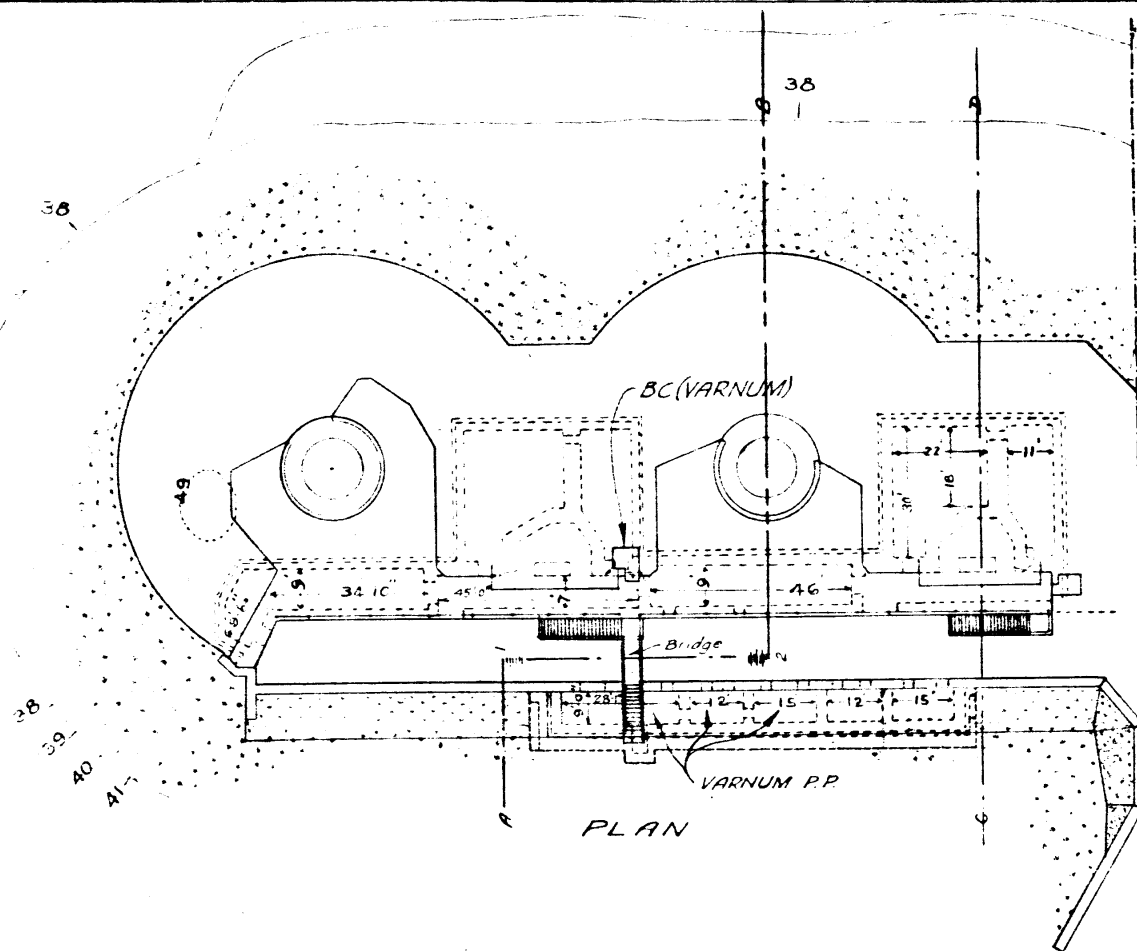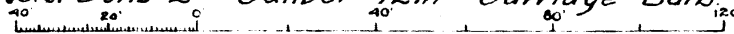

REAR ELEVATION

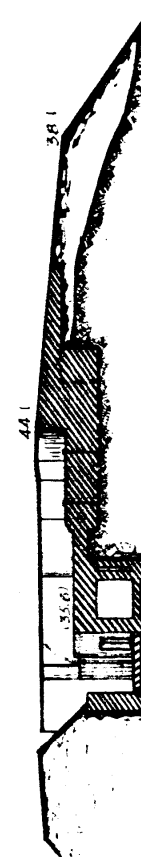

SECTION A-I-R-B

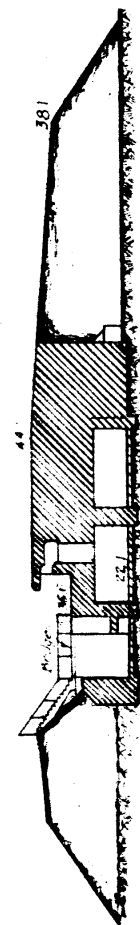

SECTION C-D

S-43
A

21
13

REPORT COMPLETED WORKS

(Battery Plan)

Corrected to Dec. 1, 1925






FORM NO. 7

HARBOR DEFENSES OF NARRAGANSETT BAY

FORT WETHERILL, R.I.

BATTERY WALBACH

No. of Guns - 3 Caliber - 10 in. Carriage Dis.

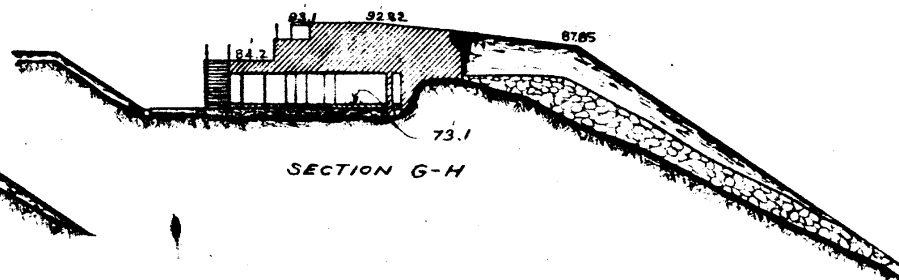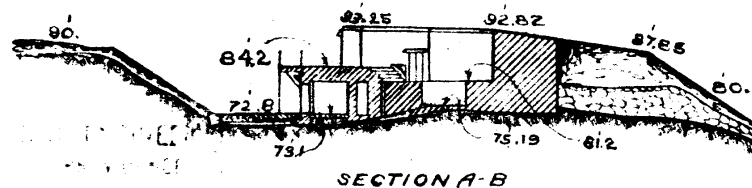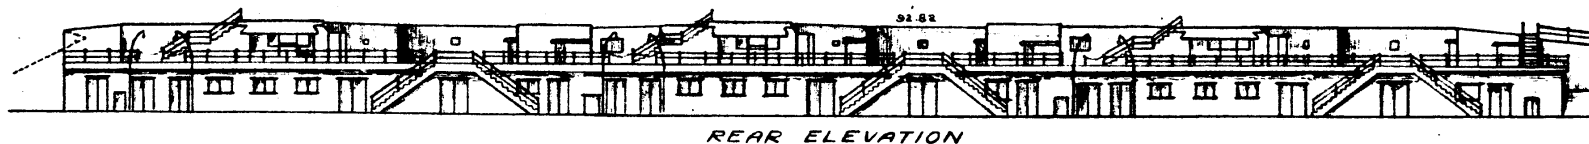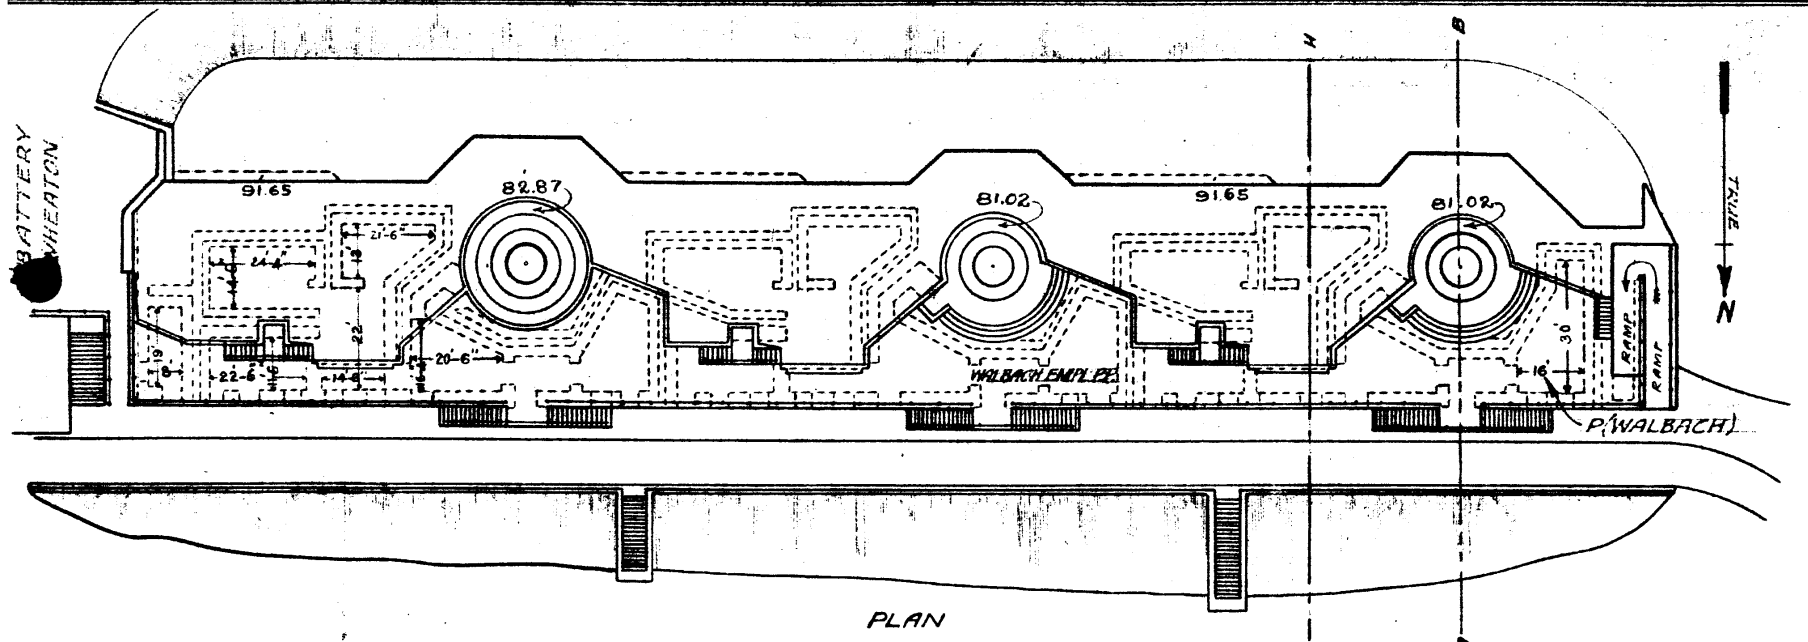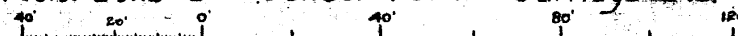

S-43 22
A 1

REPORT OF COMPLETED WORKS

(Battery Plan)

Corrected to Dec. 1, 1925

HARBOR DEFENSES OF NARRAGANSETT BAY


FORT WETHERILL, R.I.

BATTERY WHEATON

No. of Guns - 2, Caliber - 12 in. Carriage - Dis.


FORM NO. 7

40' 20' 0' 40' 80' 120'

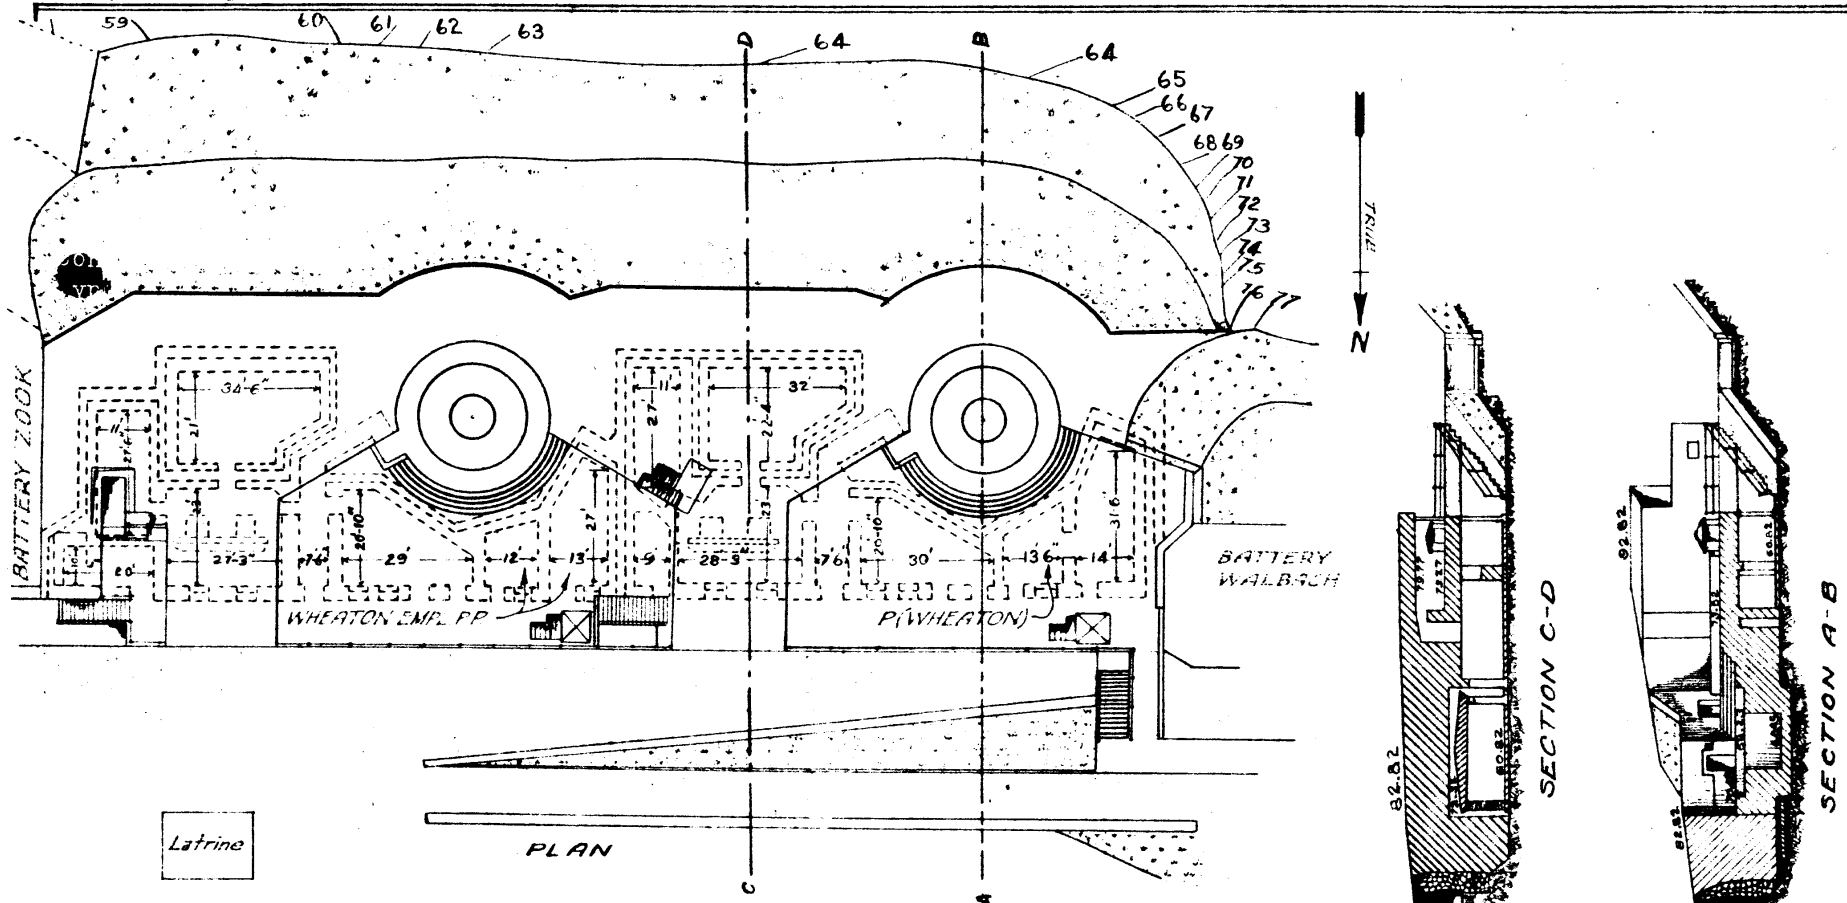

Latrine

PLAN

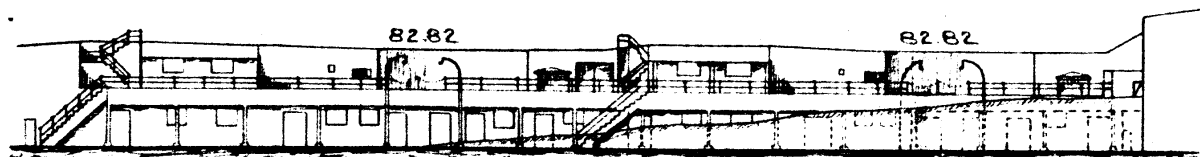


REAR ELEVATION

S-43


A

16

1

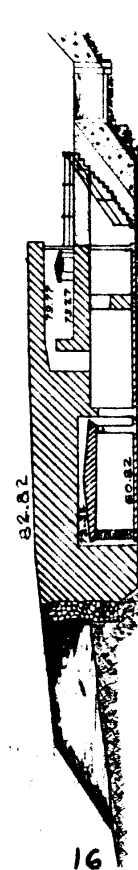

SECTION C-D

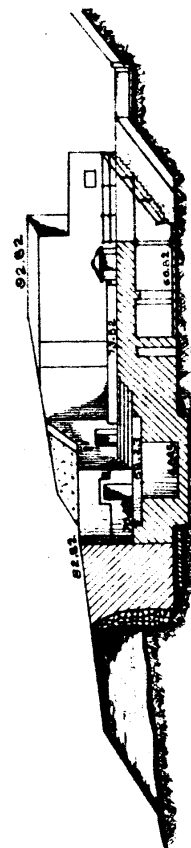

SECTION A-B

REPORT OF COMPLETED WORKS

(Battery Plan)

Corrected to Dec 1, 1925


FORM NO. 7

HARBOR DEFENSES OF NARRAGANSETT BAY.

FORT GETTY, R.I.

BATTERY WHITING

No. of Guns-2 Caliber-3in. Carriage Barb.

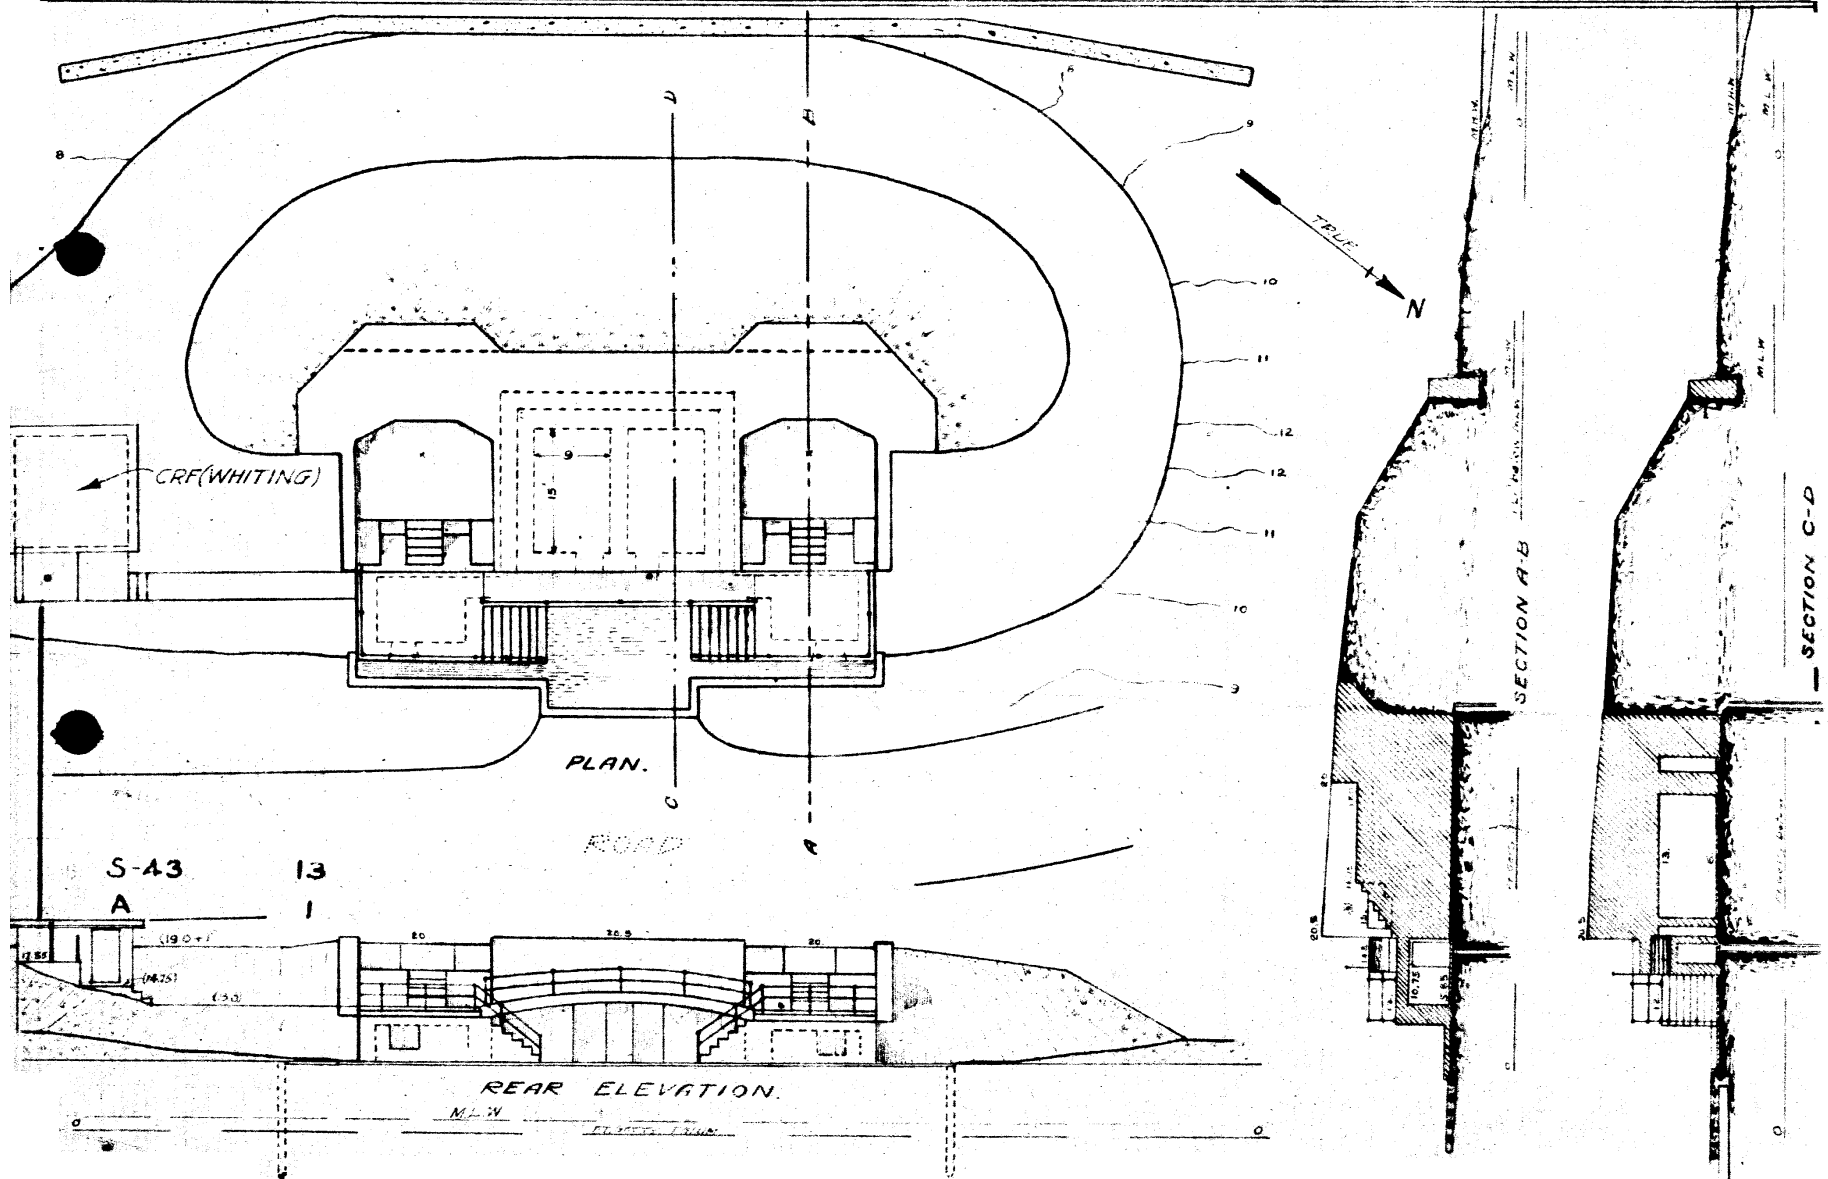

REPORT OF COMPLETED WORKS

(Battery Plan)

Corrected to Dec. 1, 1925



HARBOR DEFENSES OF NARRAGANSETT BAY.

FORT WETHERILL, R.I.


BATTERY ZOOK.

No. of Guns - 3 Caliber - 6 in. Carriage - Dis.

FORM NO. 7

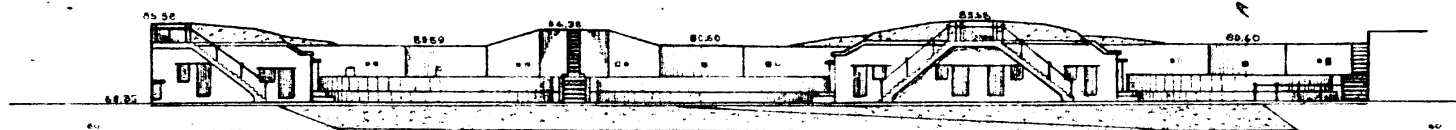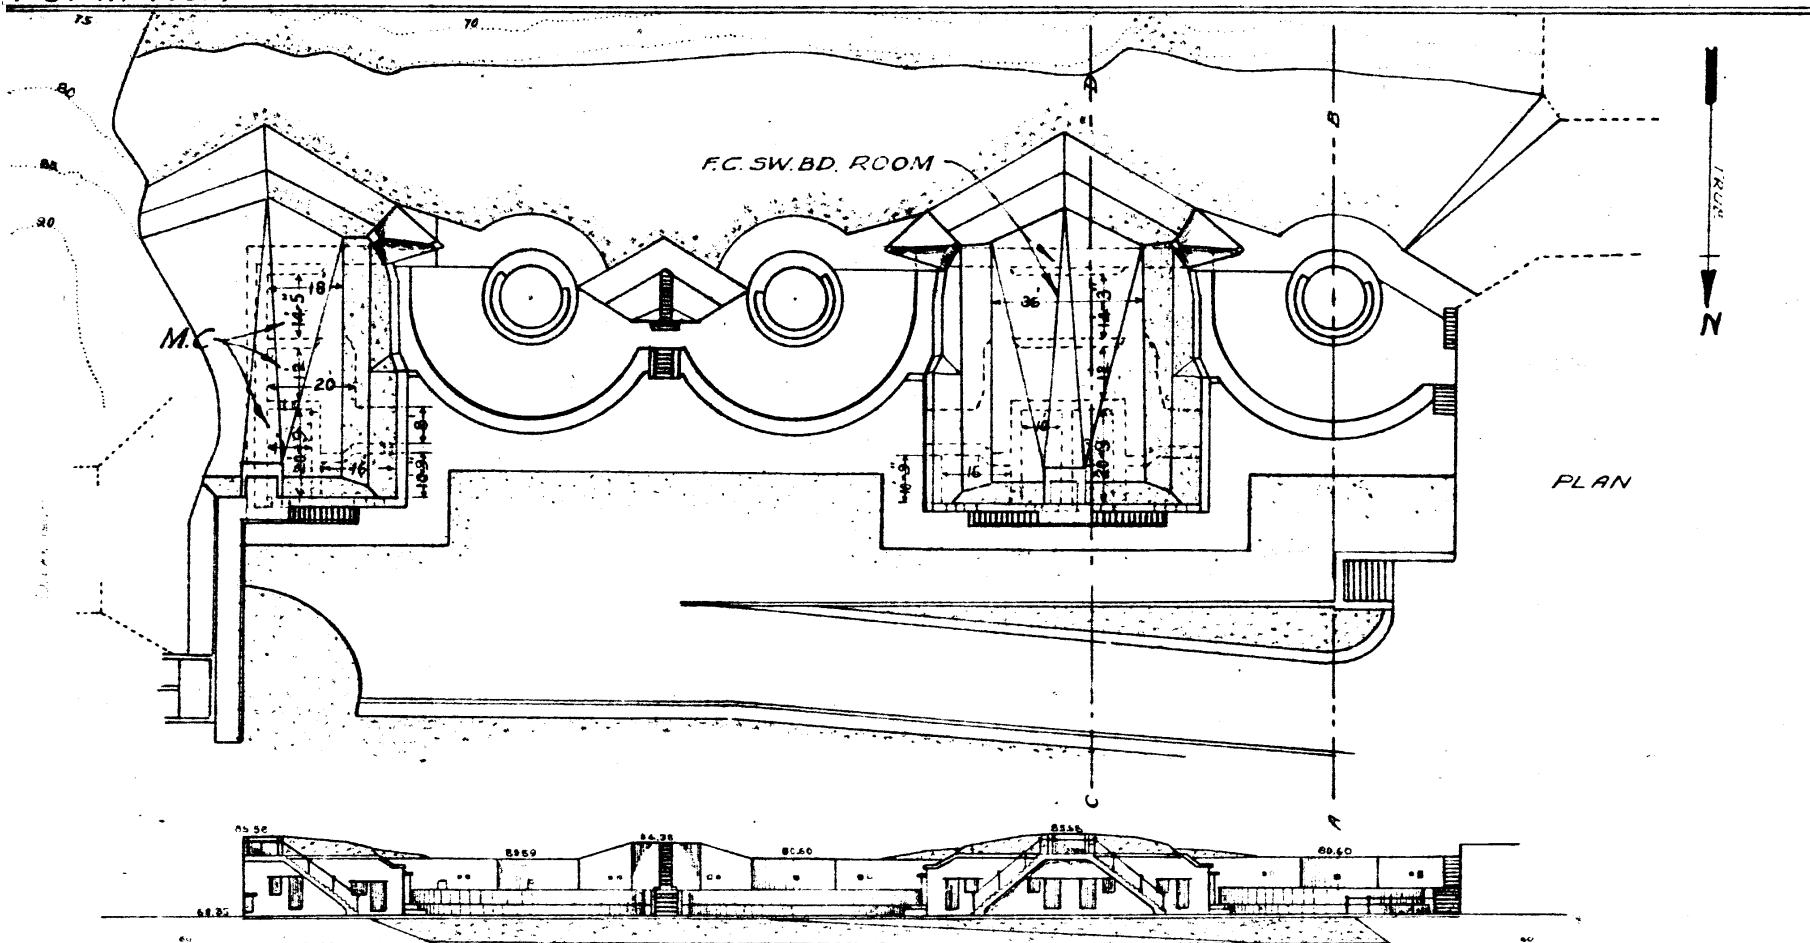

REAR ELEVATION

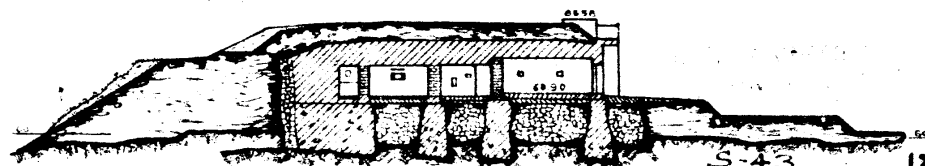


SECTION C-D


S-43

A

17

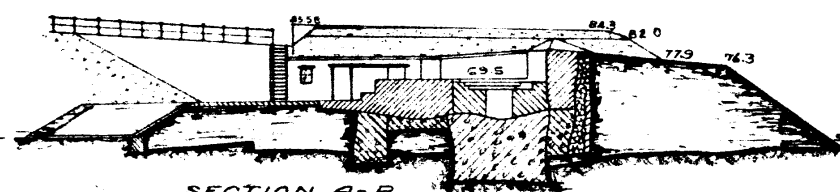

SECTION A-B

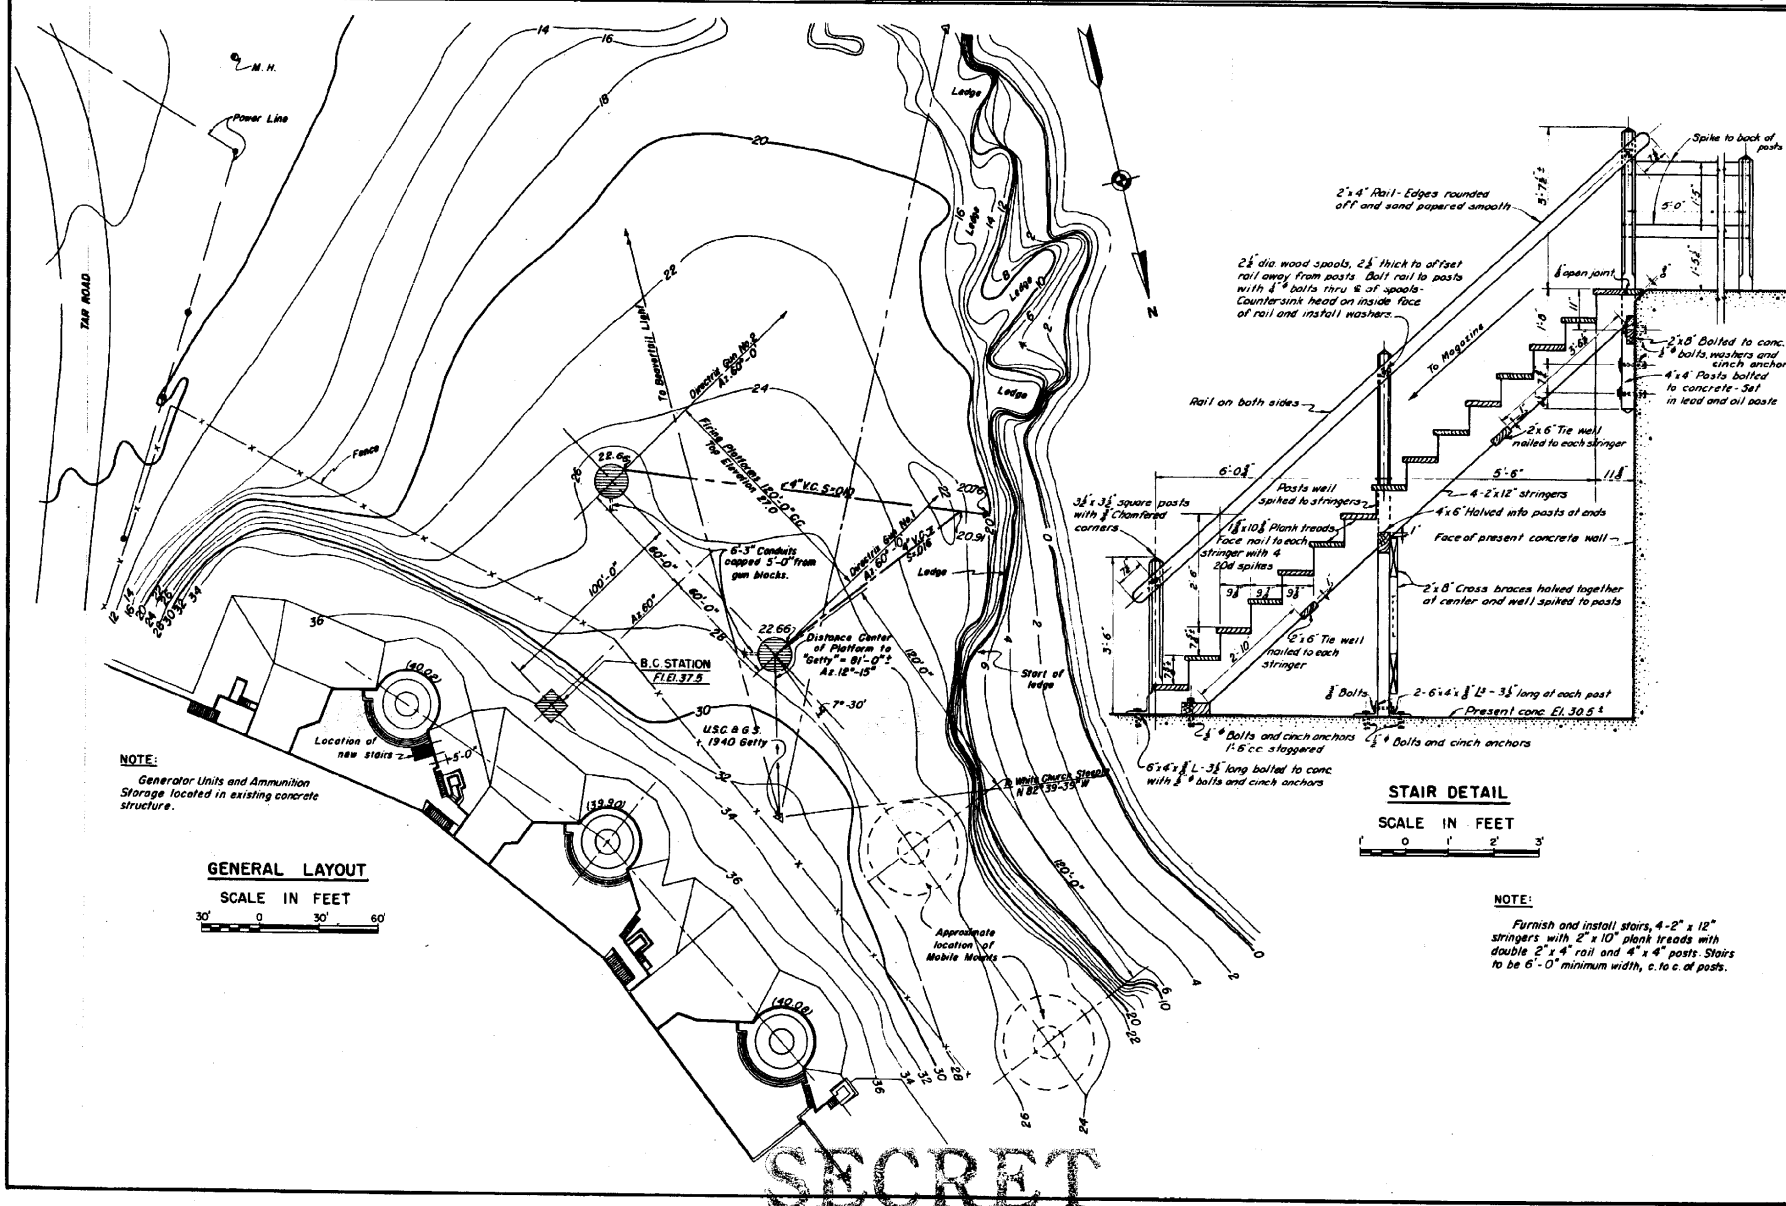

REPORT OF COMPLETED WORKS
AMTB BATTERY - NO. 922

SECRET



HARBOR DEFENSES OF NARRAGANSETT BAY
FORT GETTY, RHODE ISLAND

SCALE AS SHOWN



FORM 7

CORRECTED TO SEPTEMBER 1944


Sheet 2 of 3

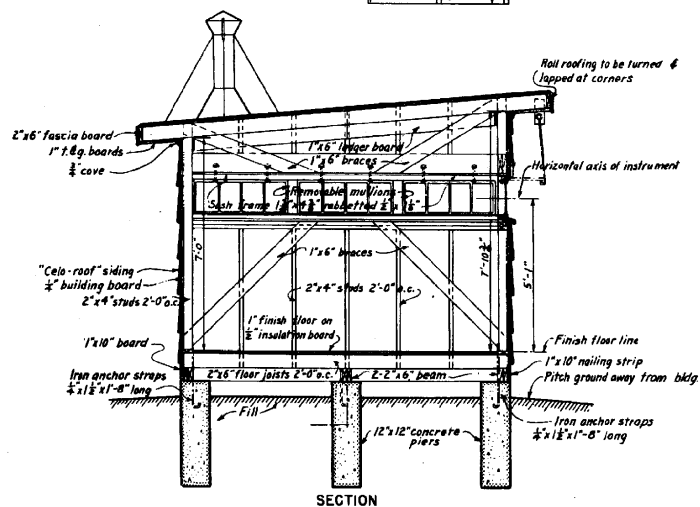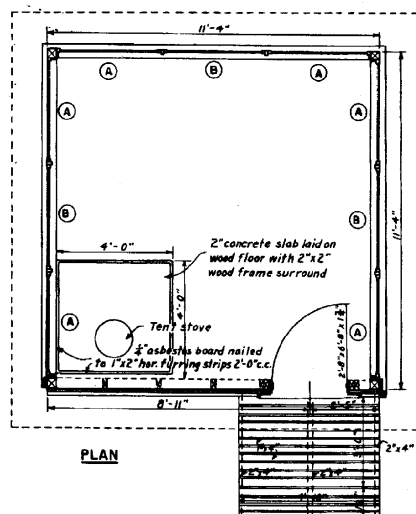

B.C. STATION

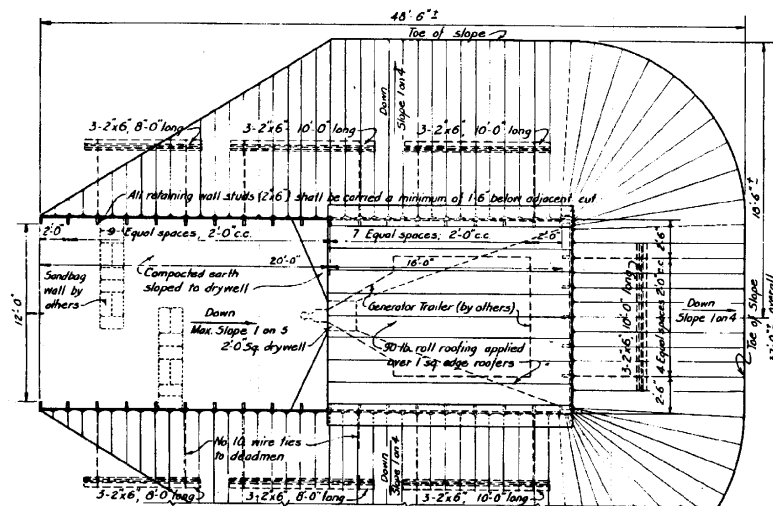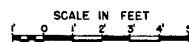

ROOF PLAN

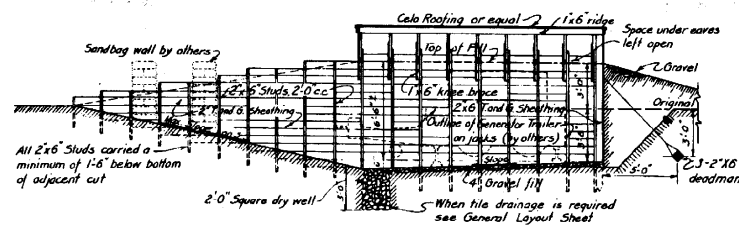

SECTION

TYPICAL GENERATOR REVETMENT




SECRET



NOTES:

Future pavement to be constructed under another unit of construction.

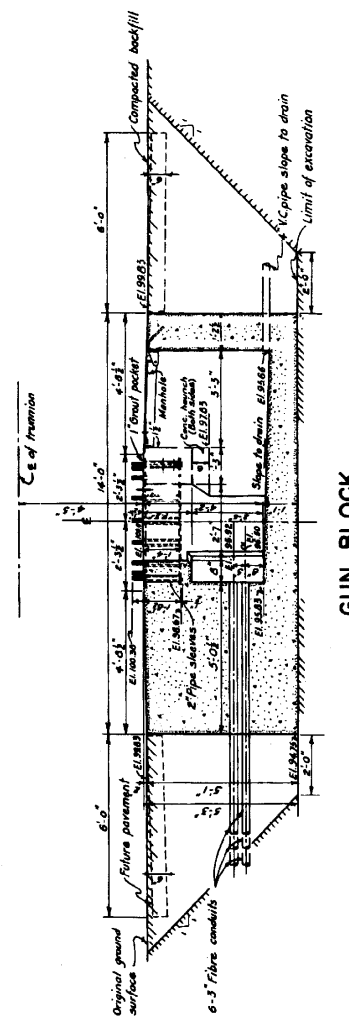

GUN BLOCK


SECRET

~~SECRET~~

SCALE IN FEET

CORRECTED TO SEPTEMBER 1944

Sheet 1 of 4

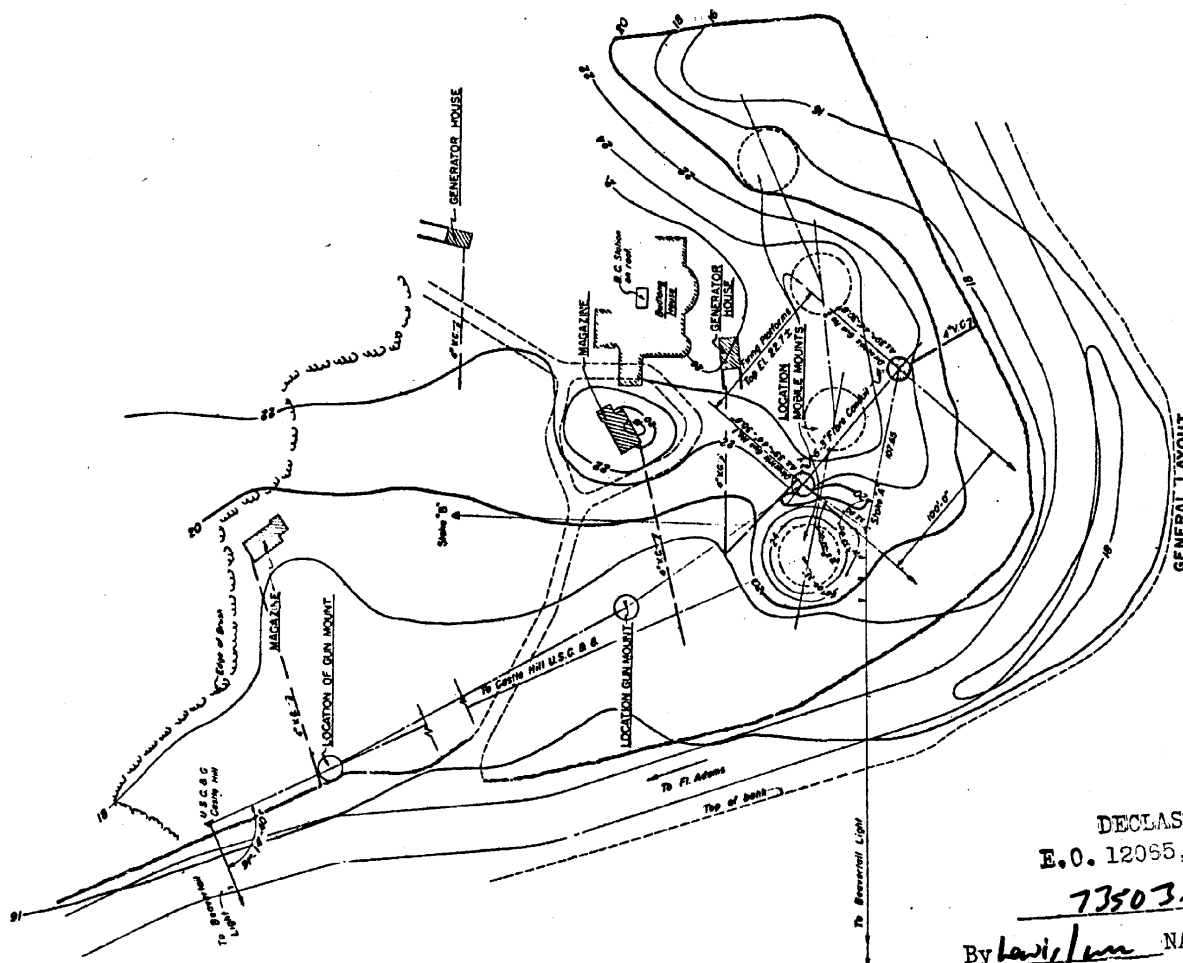

DECLASSIFIED
E.O. 12065, Sec. 3-402
735036
By Lewis/Lum NARS, Date 8/5/90

~~SECRET~~ ~~SECRET~~


SCALE IN FEET

Sheet 2 of 4

Sheet 2 of 4

344

FORM 7

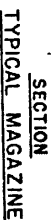

SECRET

REPORT OF COMPLETED WORKS

BATTERY CONSTRUCTION - NO. 109

~~SECRET~~

HARBOR DEFENSES OF NARRAGANSETT BAY

FORT GREENE, RHODE ISLAND



NO. OF GUNS 2, CALIBER 16", CARRIAGE BARBETTE

SCALE AS SHOWN

FORM 7

CORRECTED TO SEPTEMBER 1944

Sheet 1 of 3

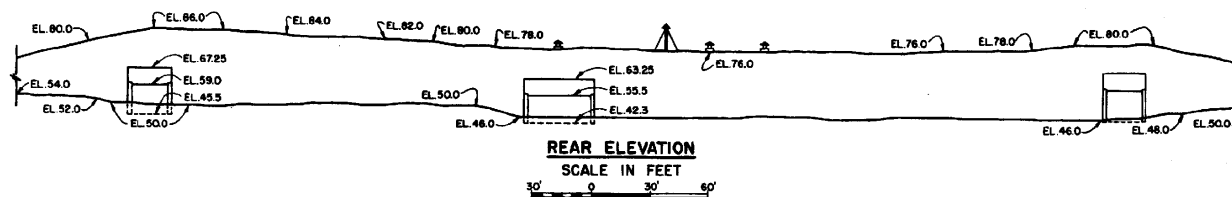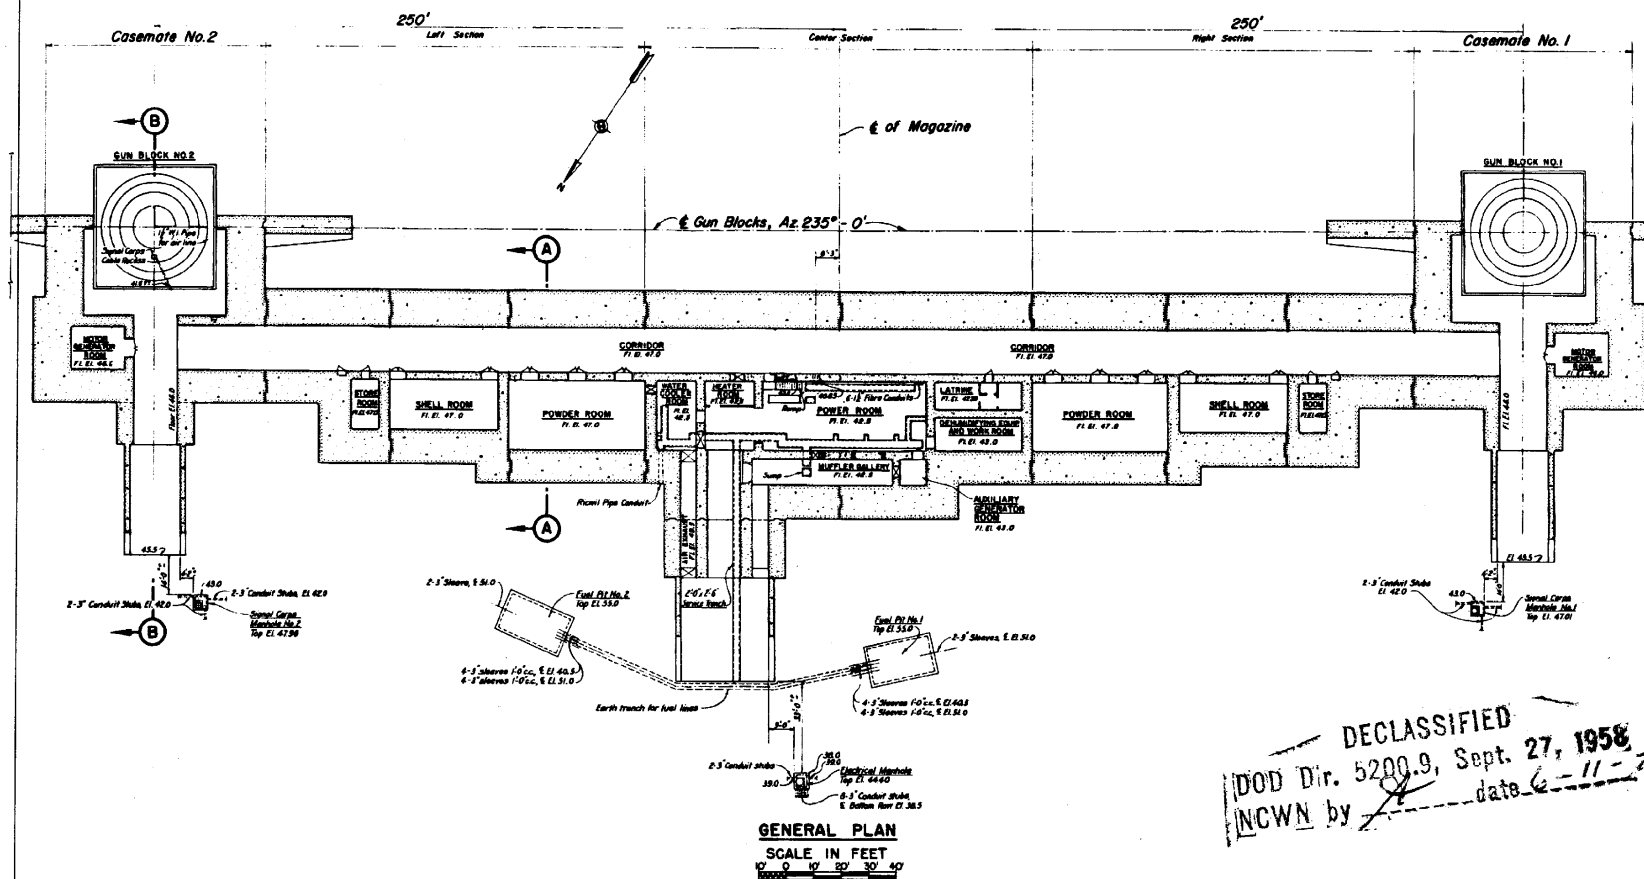

DECLASSIFIED
DOD Dir. 5200.9, Sept. 27, 1958
NCWN by *[signature]* date 6-11-70

~~SECRET~~

REPORT OF COMPLETED WORKS

BATTERY CONSTRUCTION - NO. 109

~~SECRET~~

HARBOR DEFENSES OF NARRAGANSETT BAY

FORT GREENE, RHODE ISLAND


NO. OF GUNS 2, CALIBER 16", CARRIAGE BARBETTE

SCALE AS SHOWN

FORM 7


CORRECTED TO SEPTEMBER 1944

Sheet 2 of 3

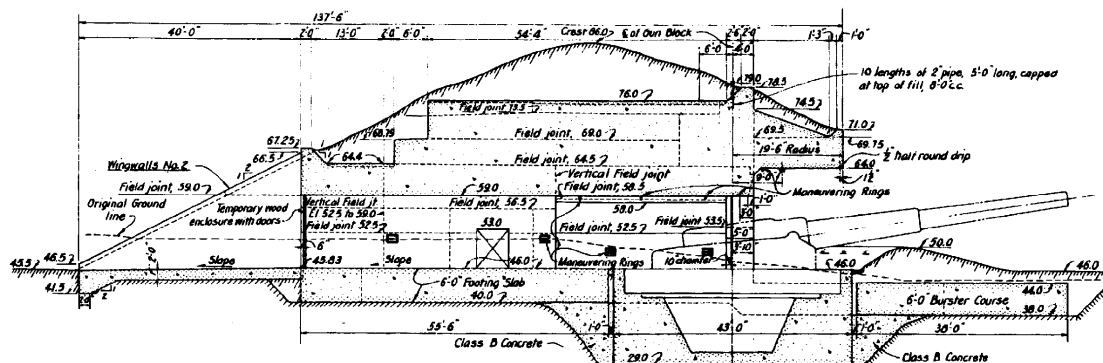

SECTION B

SCALE IN FEET

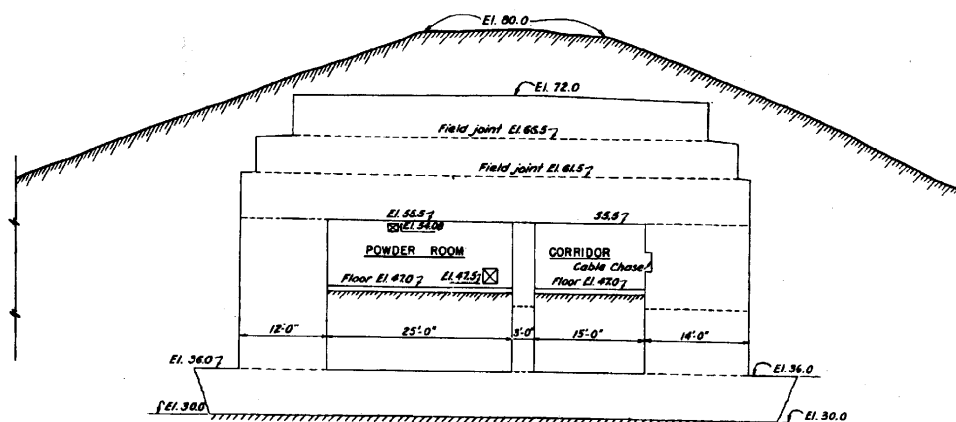

SECTION A

SCALE IN FEET



~~SECRET~~

REPORT OF COMPLETED WORKS

BATTERY CONSTRUCTION - 2II

SECRET

HARBOR DEFENSES OF NARRAGANSETT BAY

FORT GREENE, RHODE ISLAND


NO. OF GUNS 2 CALIBER 6" CARRIAGE BARBETTE

SCALE AS SHOWN

FORM 7


CORRECTED TO SEPTEMBER 1944

Sheet 1 of 2

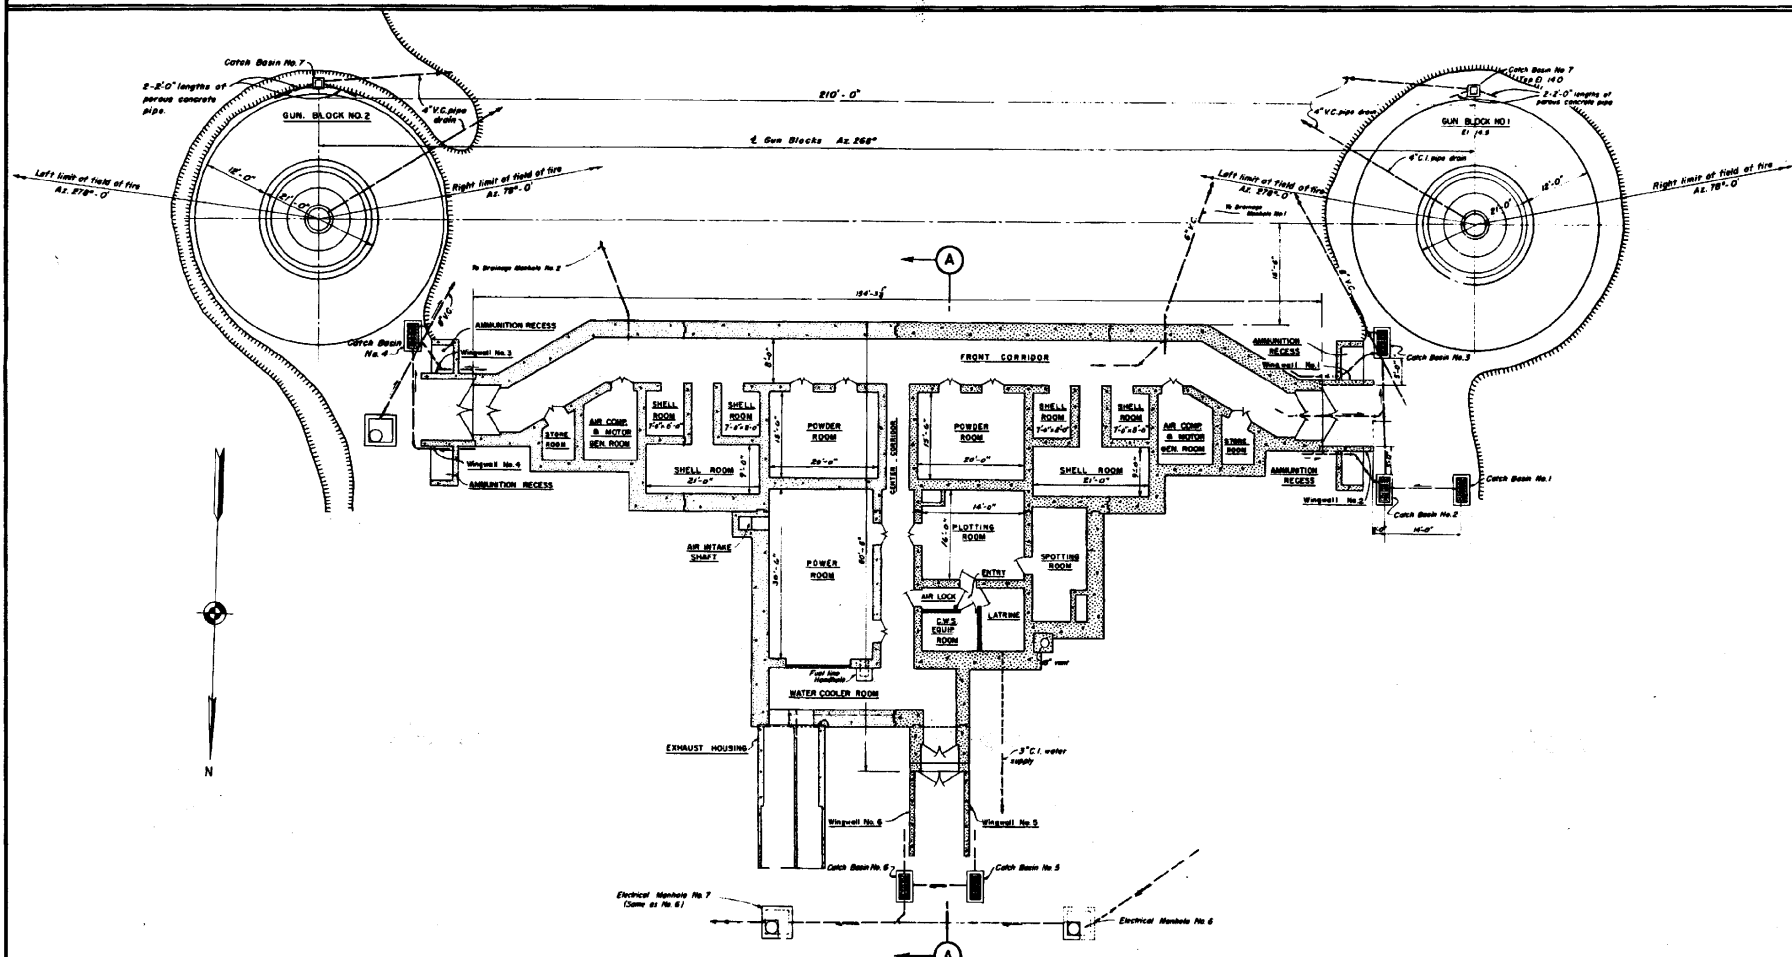

GENERAL PLAN

SCALE IN FEET
0 10 20 30 40

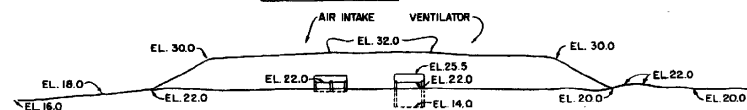

REAR ELEVATION

SCALE IN FEET
0 10 20 30 40

SECRET

REPORT OF COMPLETED WORKS
BATTERY CONSTRUCTION - NO. 211



~~SECRET~~

HARBOR DEFENSES OF NARRAGANSETT BAY
FORT GREENE, RHODE ISLAND
NO. OF GUNS - 2 CALIBER 6" CARRIAGE BARBETTE
SCALE IN FEET

FORM 7

CORRECTED TO SEPTEMBER 1944

Sheet 2 of 2

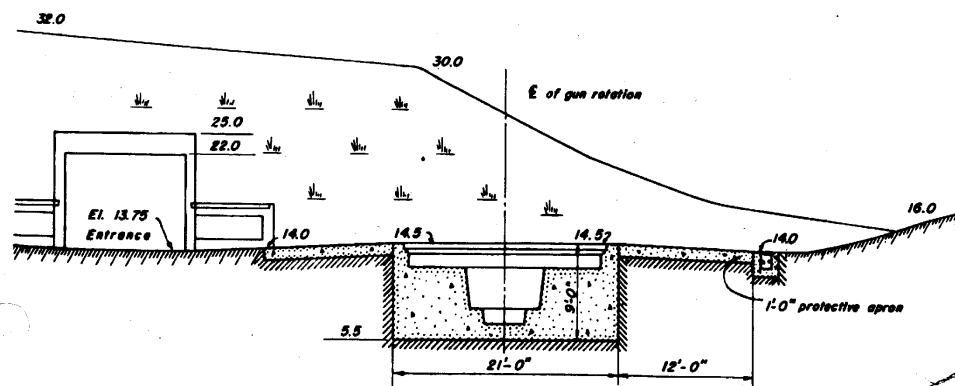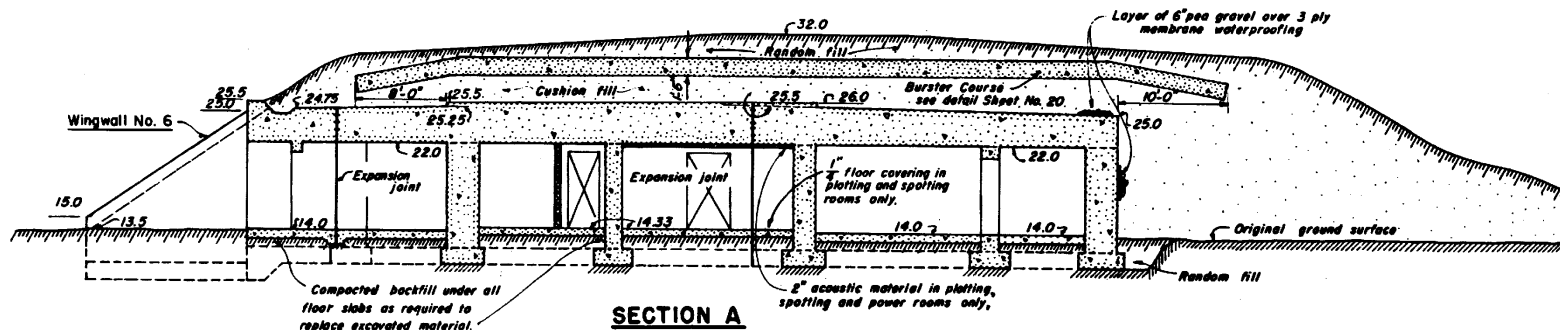

SECTION B

~~SECRET~~

DECLASSIFIED
1000 Dir. 5200.9 Sept. 27, 1950
NGWN by *[Signature]* date 6-11-70

REPORT OF COMPLETED WORKS

BATTERY CONSTRUCTION - NO. 212

SECRET

HARBOR DEFENSES OF NARRAGANSETT BAY

FORT CHURCH, RHODE ISLAND


NO. OF GUNS 2 CALIBER 6" CARRIAGE BARBETTE

SCALE AS SHOWN

FORM 7

CORRECTED TO SEPTEMBER 1944

Sheet 1 of 2

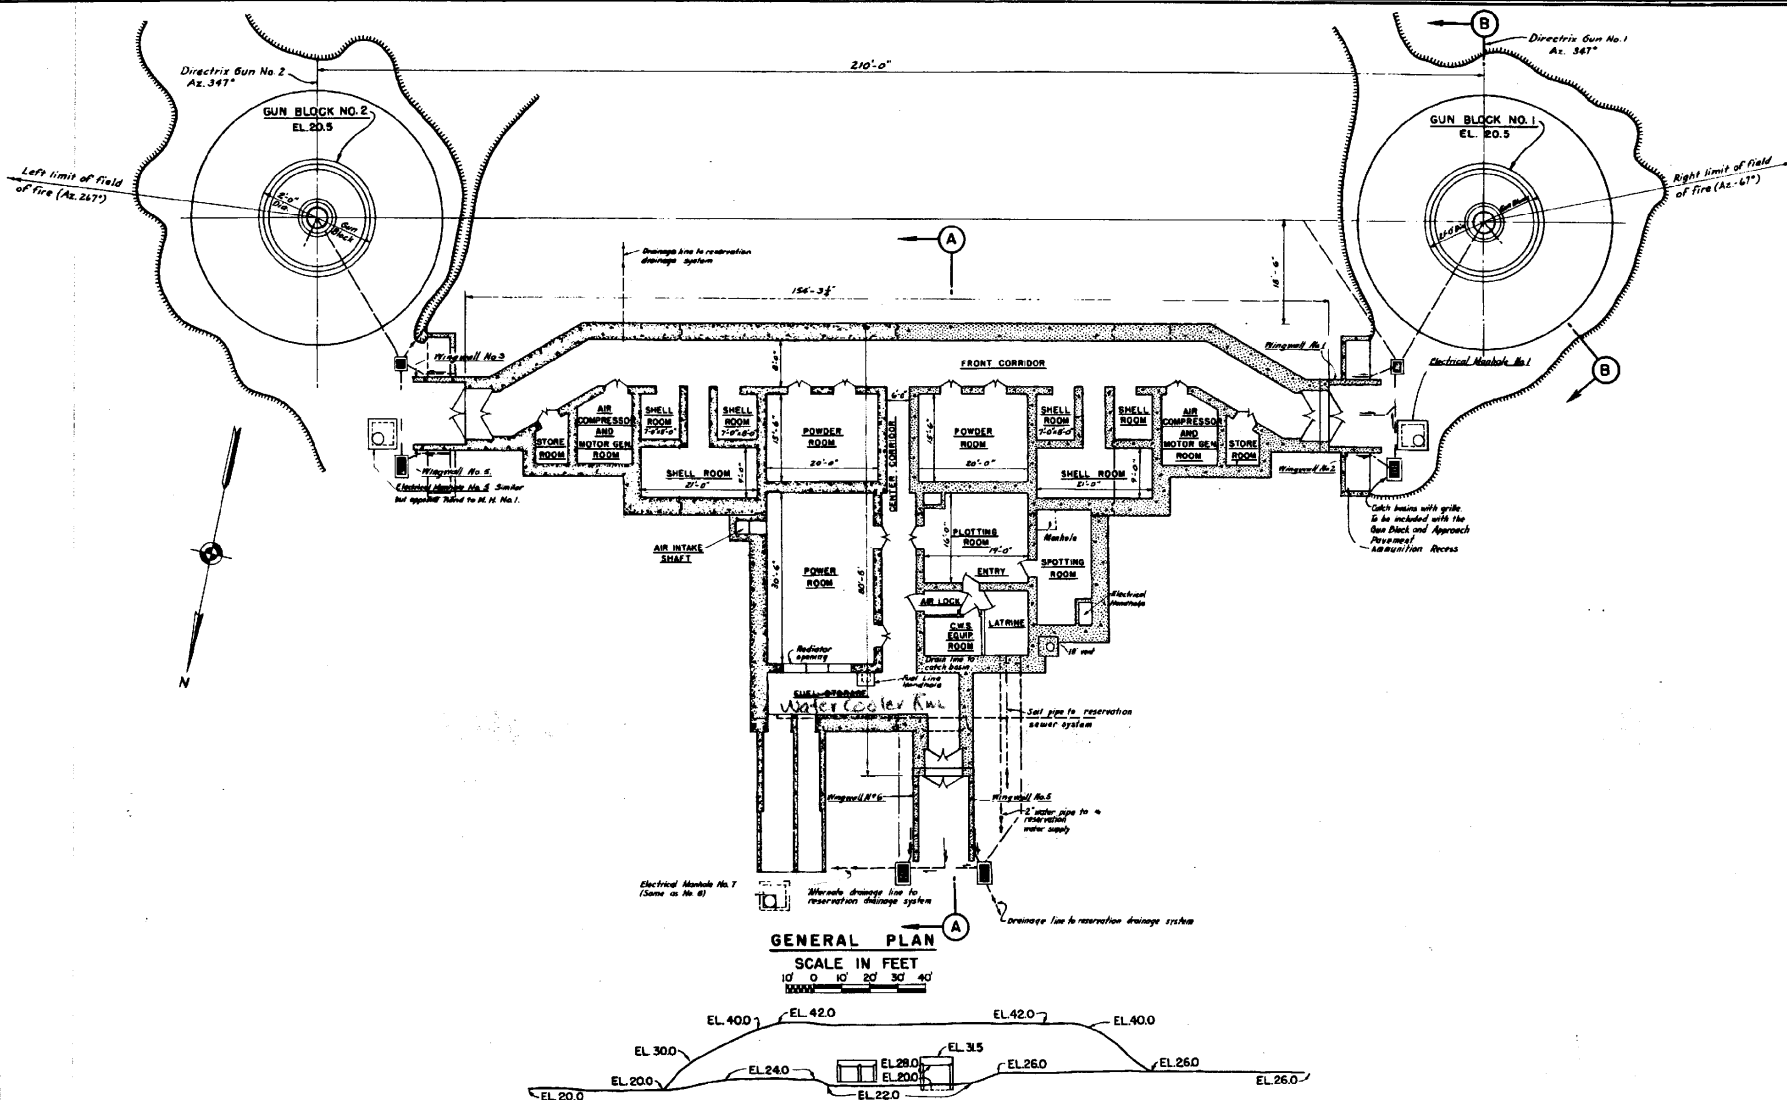

GENERAL PLAN

SCALE IN FEET

0 10 20 30 40

50000

REAR ELEVATION

SCALE IN FEET

SECRET

REPORT OF COMPLETED WORKS

BATTERY INSTRUCTION - NO. 212

FORM 7


~~SECRET~~

CORRECTED TO SEPTEMBER 1944


HARBOR DEFENSES OF LONG ISLAND SOUND
FORT CHURCH, RHODE ISLAND
NO. GUNS-2-CALIBER 6" CARRIAGE BARBETTE
SCALE IN FEET

5' 0' 5' 10' 15' 20'

Sheet 2 of 2

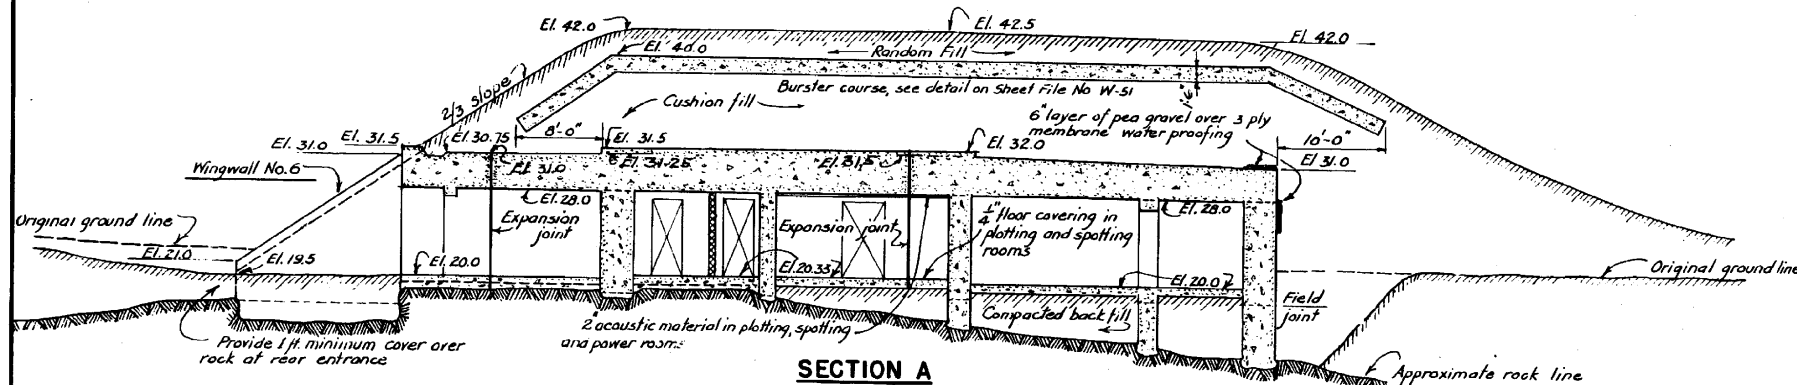

SECTION A

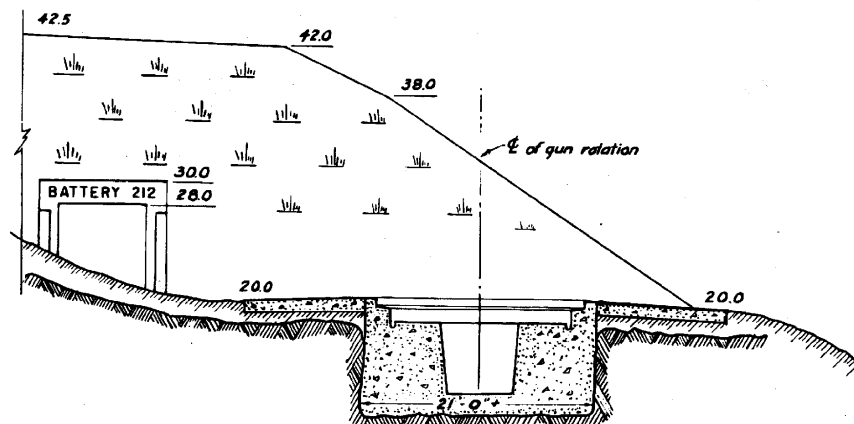

SECTION B

~~SECRET~~

BATTERY CONSTRUCTION - NO. 213


FORT BURNSIDE, RHODE ISLAND

SCALE AS SHOWN

Sheet 1 of 2

FORM 7


CORRECTED TO SEPTEMBER 1944

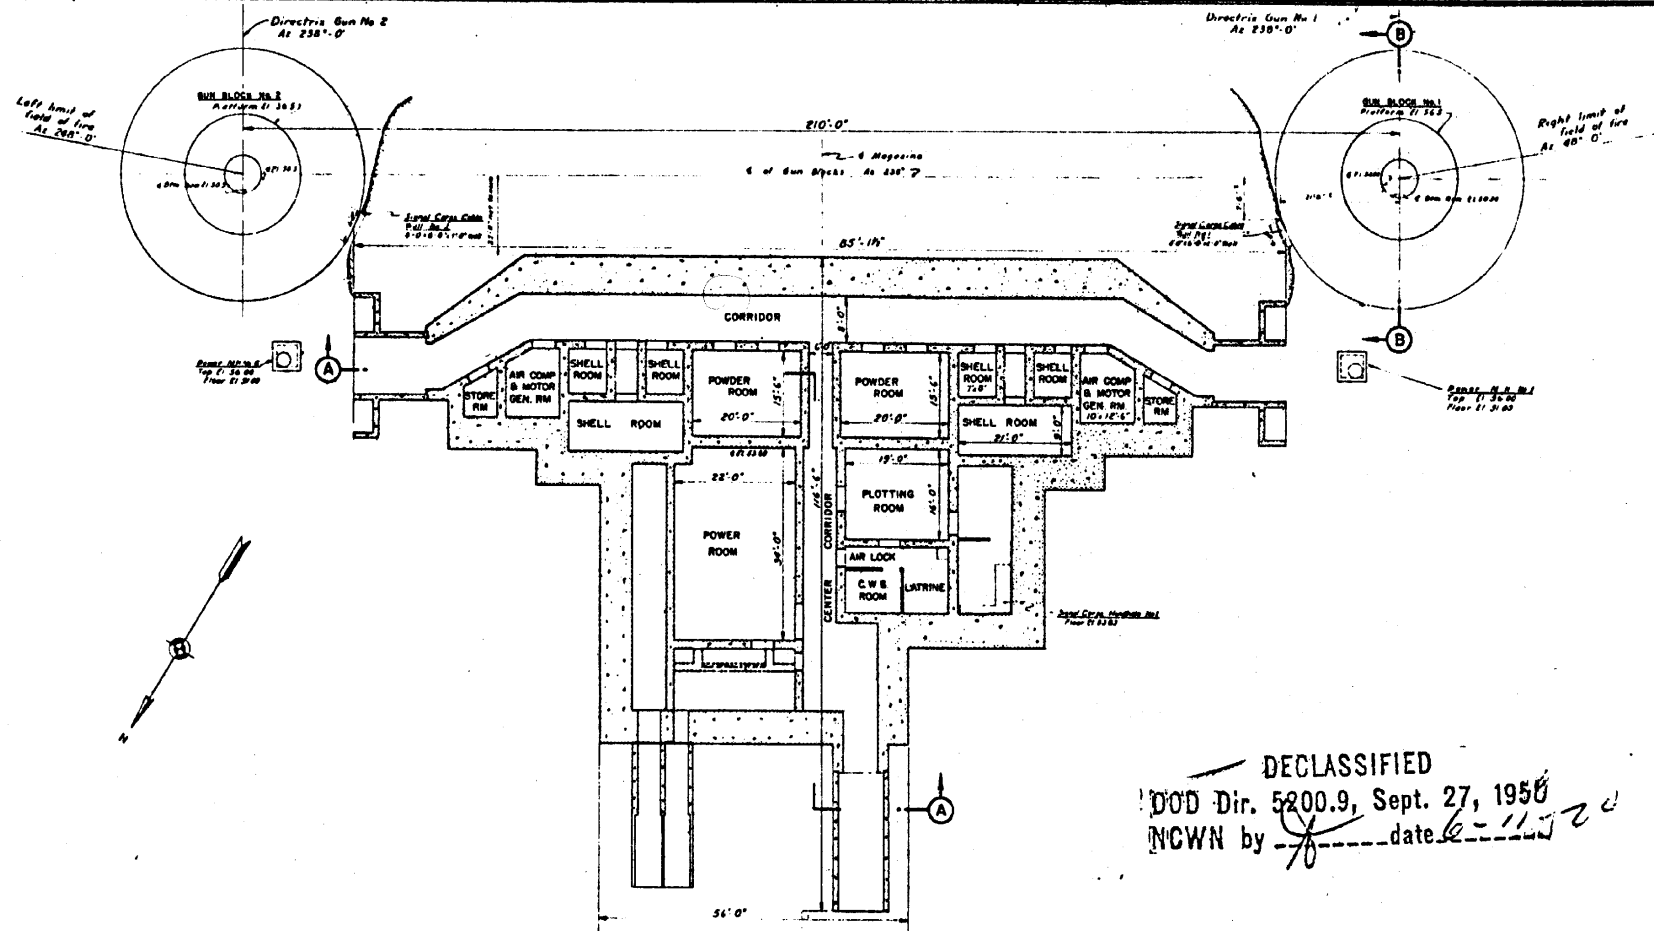

GENERAL PLAN

SCALE IN FEET
10' 0 10' 20' 30'

(Seal not in record w/dust)

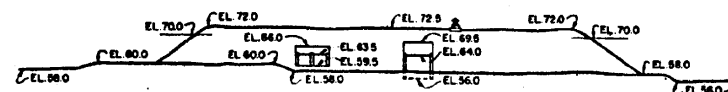

REAR ELEVATION

SCALE IN FEET

DECLASSIFIED



DECLASSIFIED
DOD Dir. 5200.9, Sept. 27, 1950

NCWN by A date 6-11-51

~~SECRET~~

SCALE IN FEET

Sheet 2 of 2

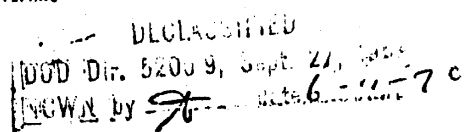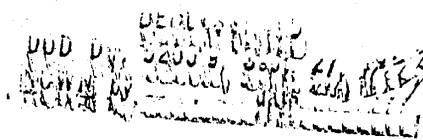

REPORT OF COMPLETED WORKS SEACOAST FORTIFICATIONS
(Battery Plan)


FORM NO.7

CORRECTED TO NOVEMBER 1942




HARBOR DEFENSES OF NARRAGANSETT BAY
BRENTON POINT RHODE ISLAND

BATTERY: (155MM. PANAMA TYPE EMPLACEMENTS)

NO. OF GUNS - 4 : CALIBER - 155MM; CARRIAGE-FIELD PIECE

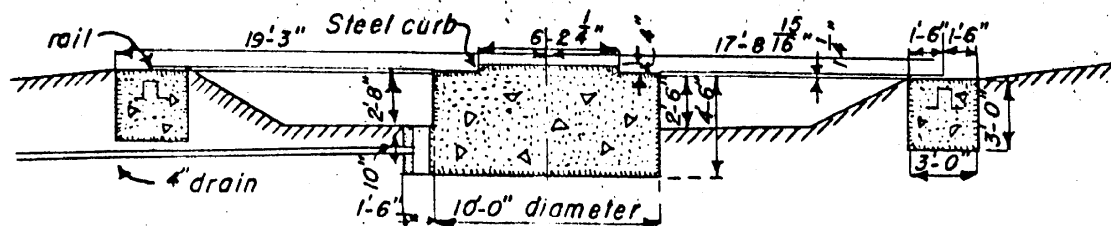


TYPICAL SECTION THROUGH GUN BLOCKS

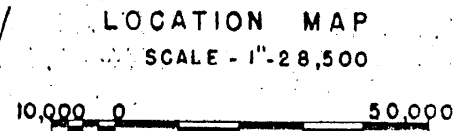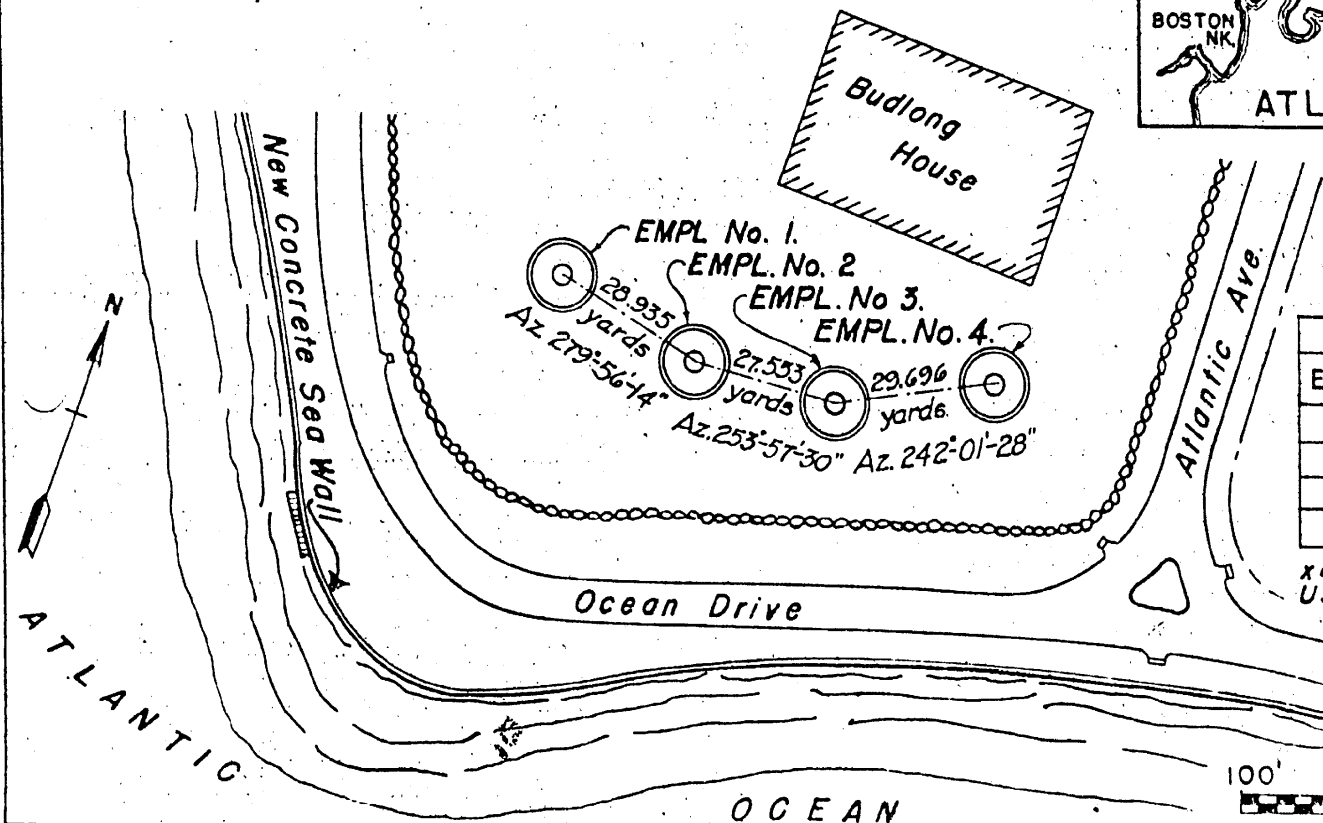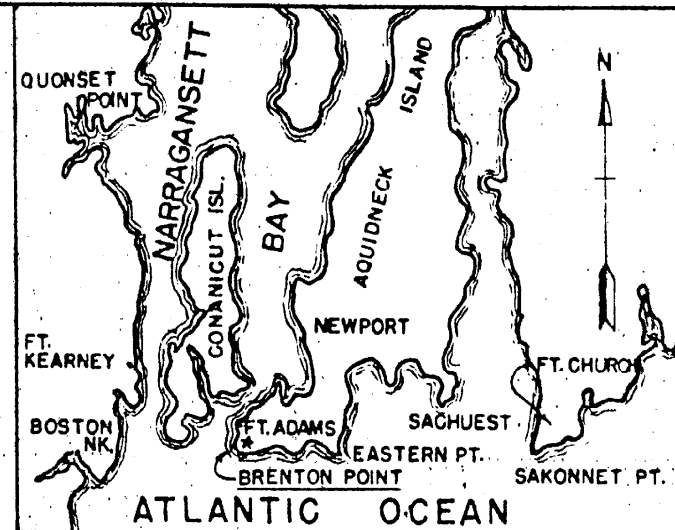

COORDINATES		
EMPL. NO.	X	Y
1	111,656.1	95,139.2
2	111,684.6	95,134.2
3	111,712.0	95,137.1
4	111,738.7	95,150.1

x & y coordinates refer to the USCAGS (Lambert for Narr. Bay) system


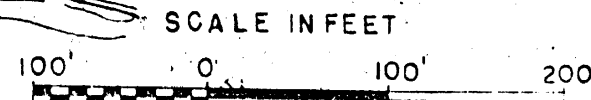


REPORT OF COMPLETED WORKS
BATTERY PLAN


HARBOR DEFENSES OF NARRAGANSETT BAY
FORT CHURCH, R.I.
BATTERY GRAY

No. of guns, 2 - Caliber, 16" - Carriage Barbette

 
Form 7 Corrected to June 1, 1942

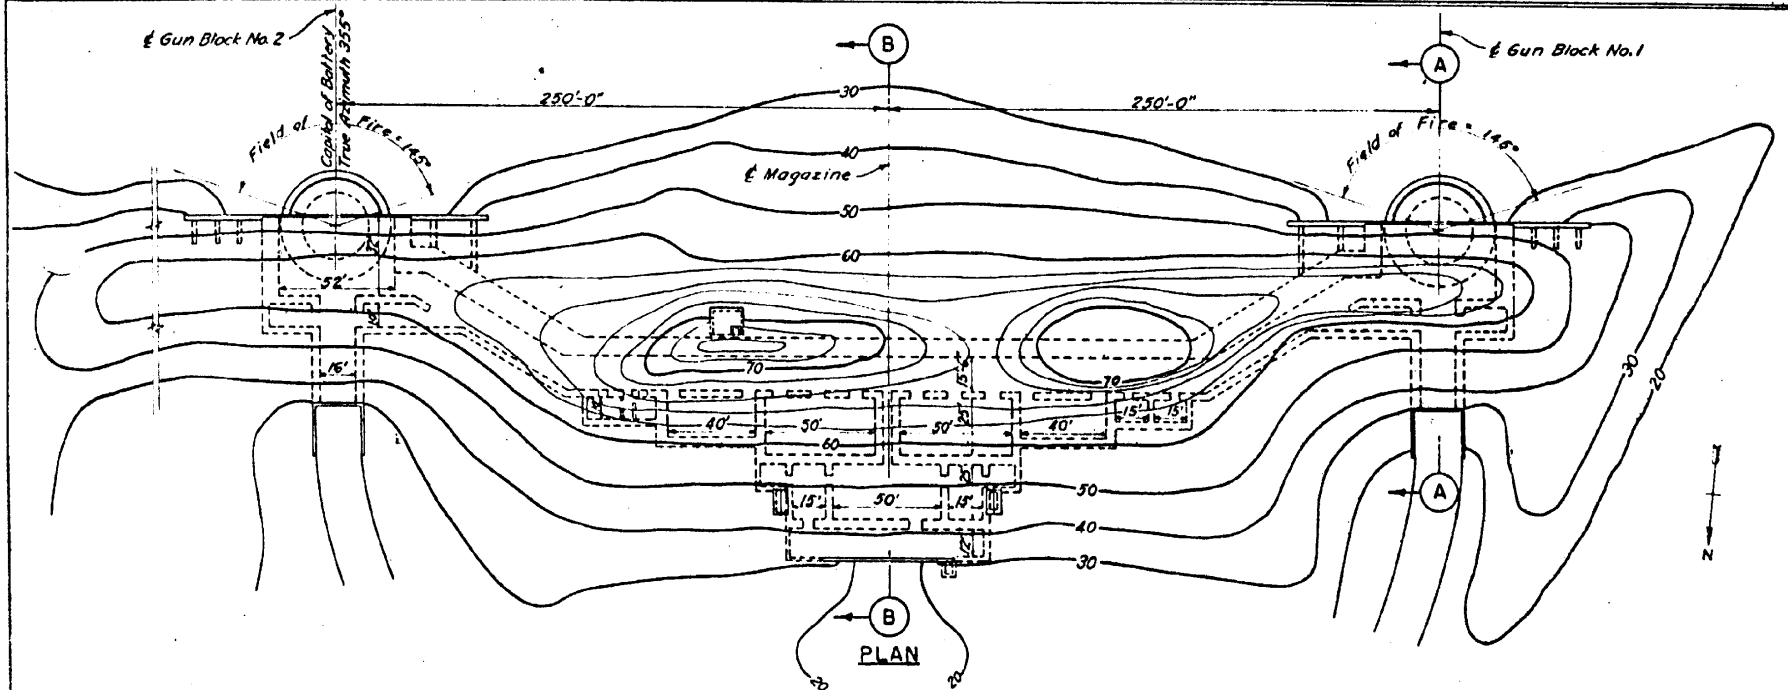

REAR ELEVATION

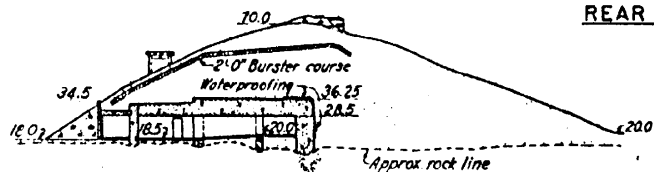

SECTION B-B

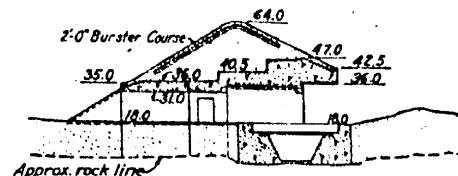

SECTION A-A

Elevations refer to Mean Low Water Datum.

BATTER: HAMILTON

~~SECRET~~


FORT GREENE, RHODE ISLAND

SCALE AS SHOWN


Sheet 1 of 3

FORM 7

CORRECTED TO SEPTEMBER 1944

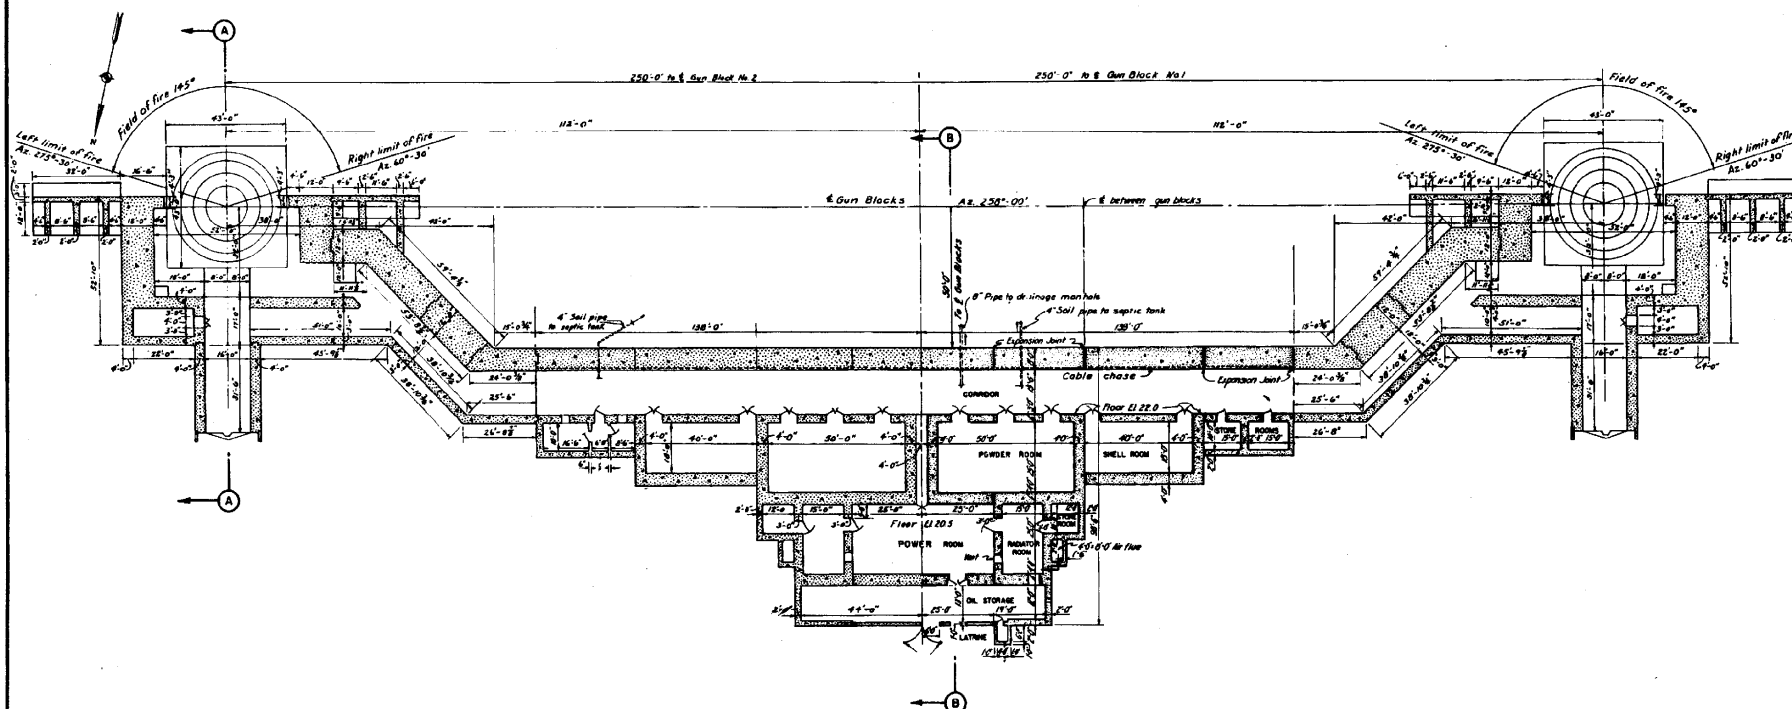

SCALE IN FEET
10' 0 10' 20' 30' 40'

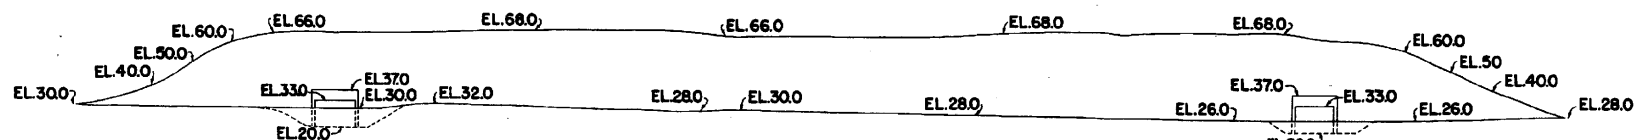

SCALE IN FEET



~~SECRET~~

DECLASSIFIED

DECLASSIFIED
DOD Dir. 5200.9, Sept. 27, 1958
NCWN by date 6-11-

BATTERY HAMILTON

~~SECRET~~

FORT GREENE, RHODE ISLAND



NO. OF GUNS 2 CALIBER 16 INCH CARRIAGE BARBETTE

SCALE AS SHOWN

Sheet 2 of 3

FORM 7


CORRECTED TO SEPTEMBER 1944

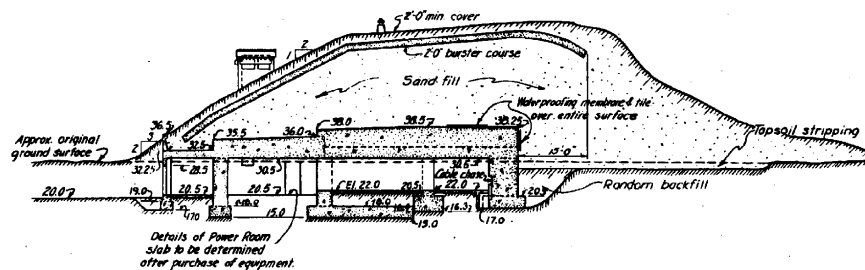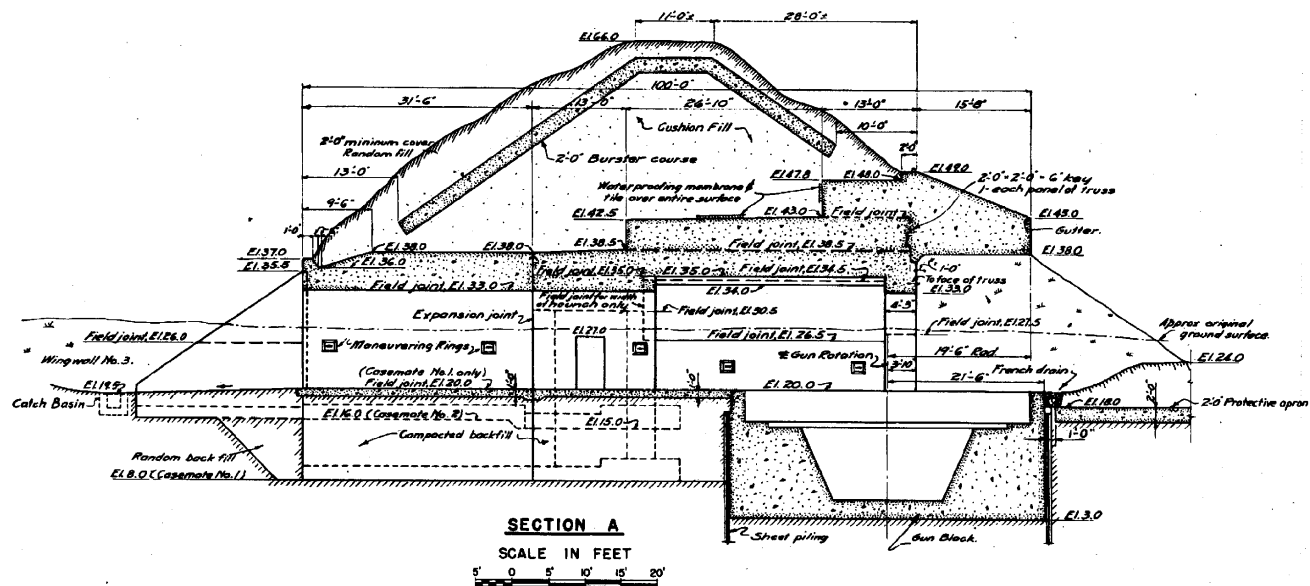

SECTION B
SCALE IN FEET

~~SECRET~~

SECRET

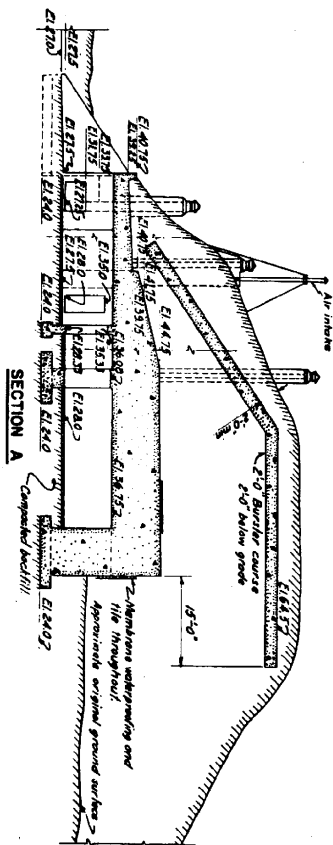

BATTERY HAMILTON
PLOTTING ROOM
FORT GREENE, RHODE ISLAND
HARBOR DEFENSES OF NARRAGANSETT BAY

REPORT OF COMPLETED WORKS
BATTERY PLAN


HARBOR DEFENSES OF NARRAGANSETT BAY
BOSTON NECK, R.I.
BATTERY HOUSE

No. of guns — 2, Caliber — 6" R.F., Carriage — Barbette

FORM 7

CORRECTED TO NOVEMBER 1942

20' 0' 20' 40' 60' 80' 100' 120' 140'

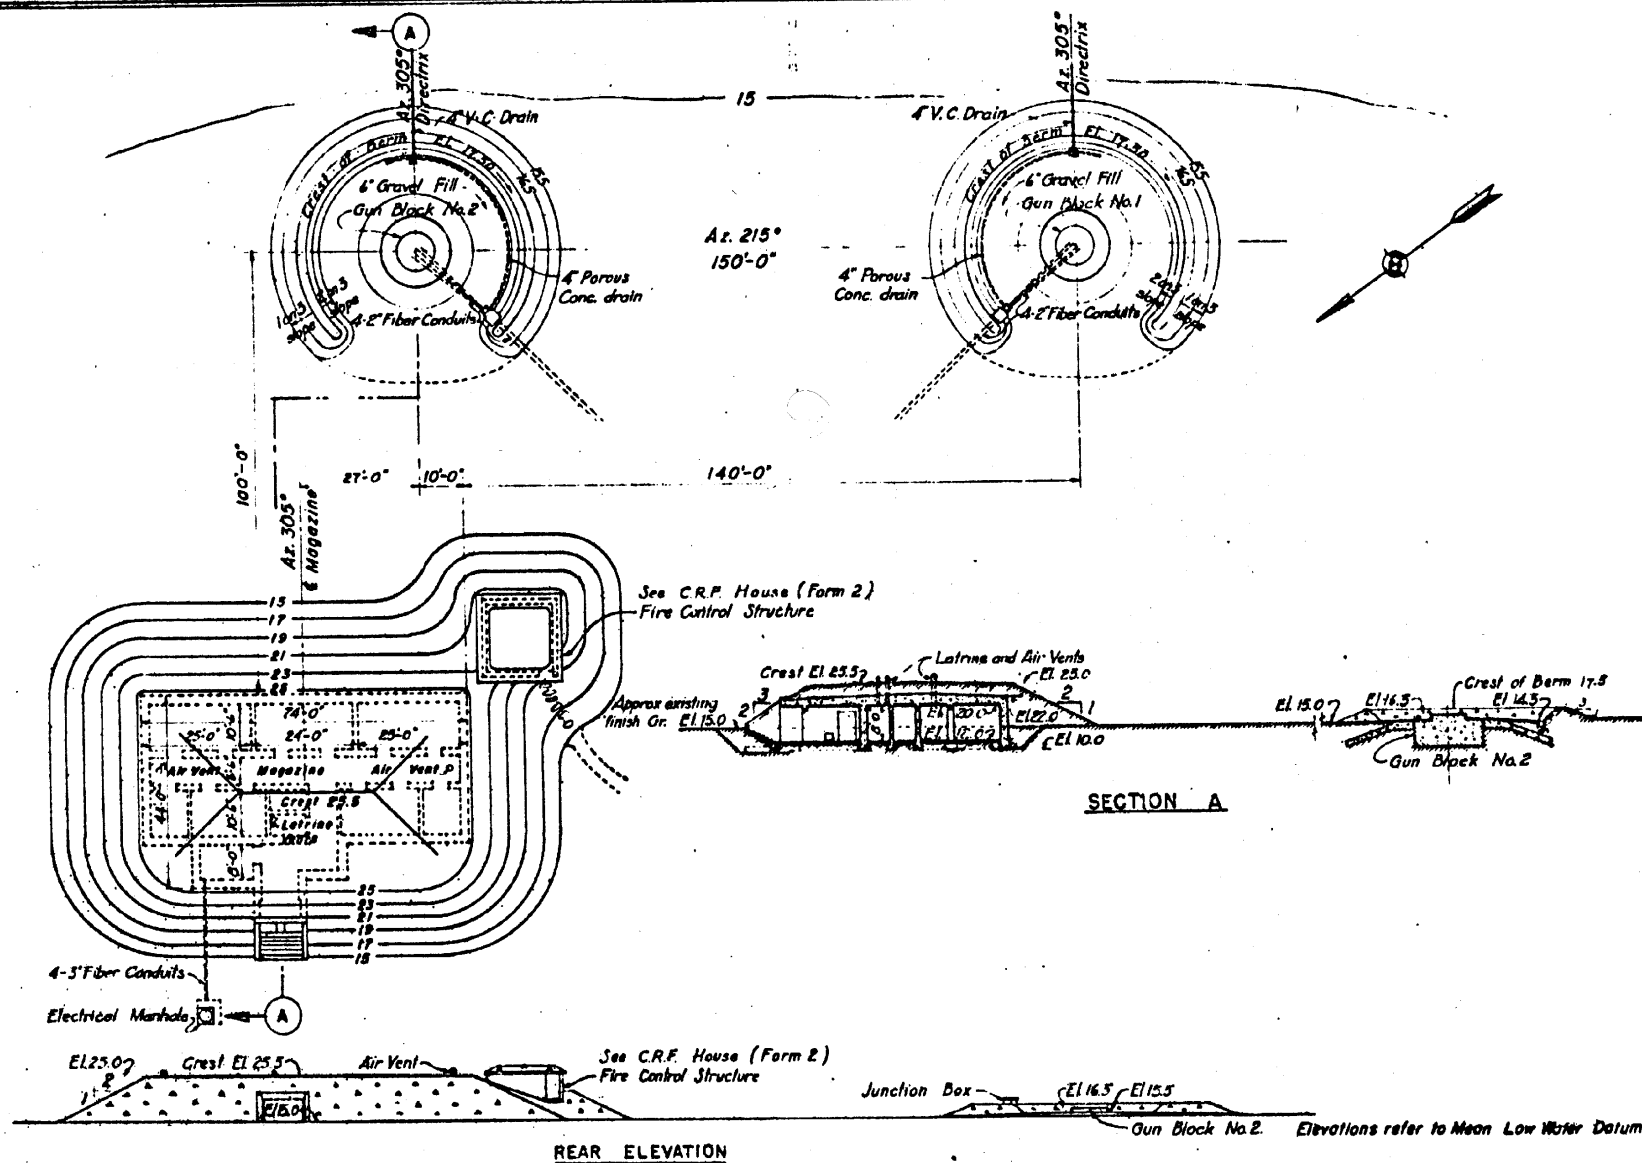


REPORT OF COMPLETED WORKS - SEACOAST FORTIFICATIONS
(Battery Plan)


FORM NO. 7

CORRECTED TO NOVEMBER 1942.

HARBOR DEFENSES OF NARRAGANSETT BAY
POINT JUDITH, NARRAGANSETT, RHODE ISLAND.
BATTERY (155MM. PANAMA TYPE EMPLACEMENTS)
NO. OF GUNS - 4; CALIBER - 155MM.; CARRIAGE - FIELD PIECE.

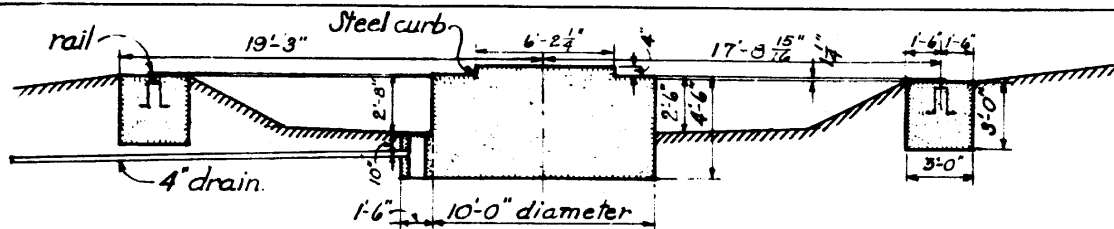


TYPICAL SECTION THROUGH GUN BLOCKS

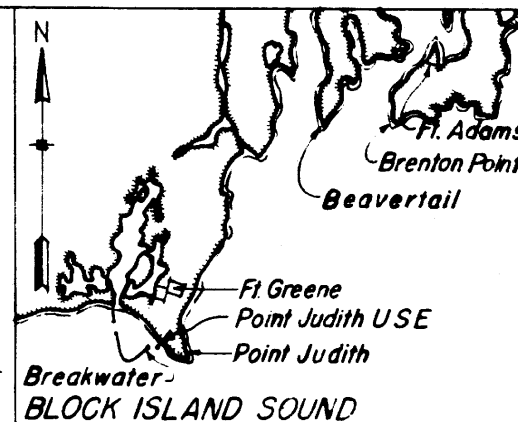

LOCATION MAP
scale in yards

0 5000 10000




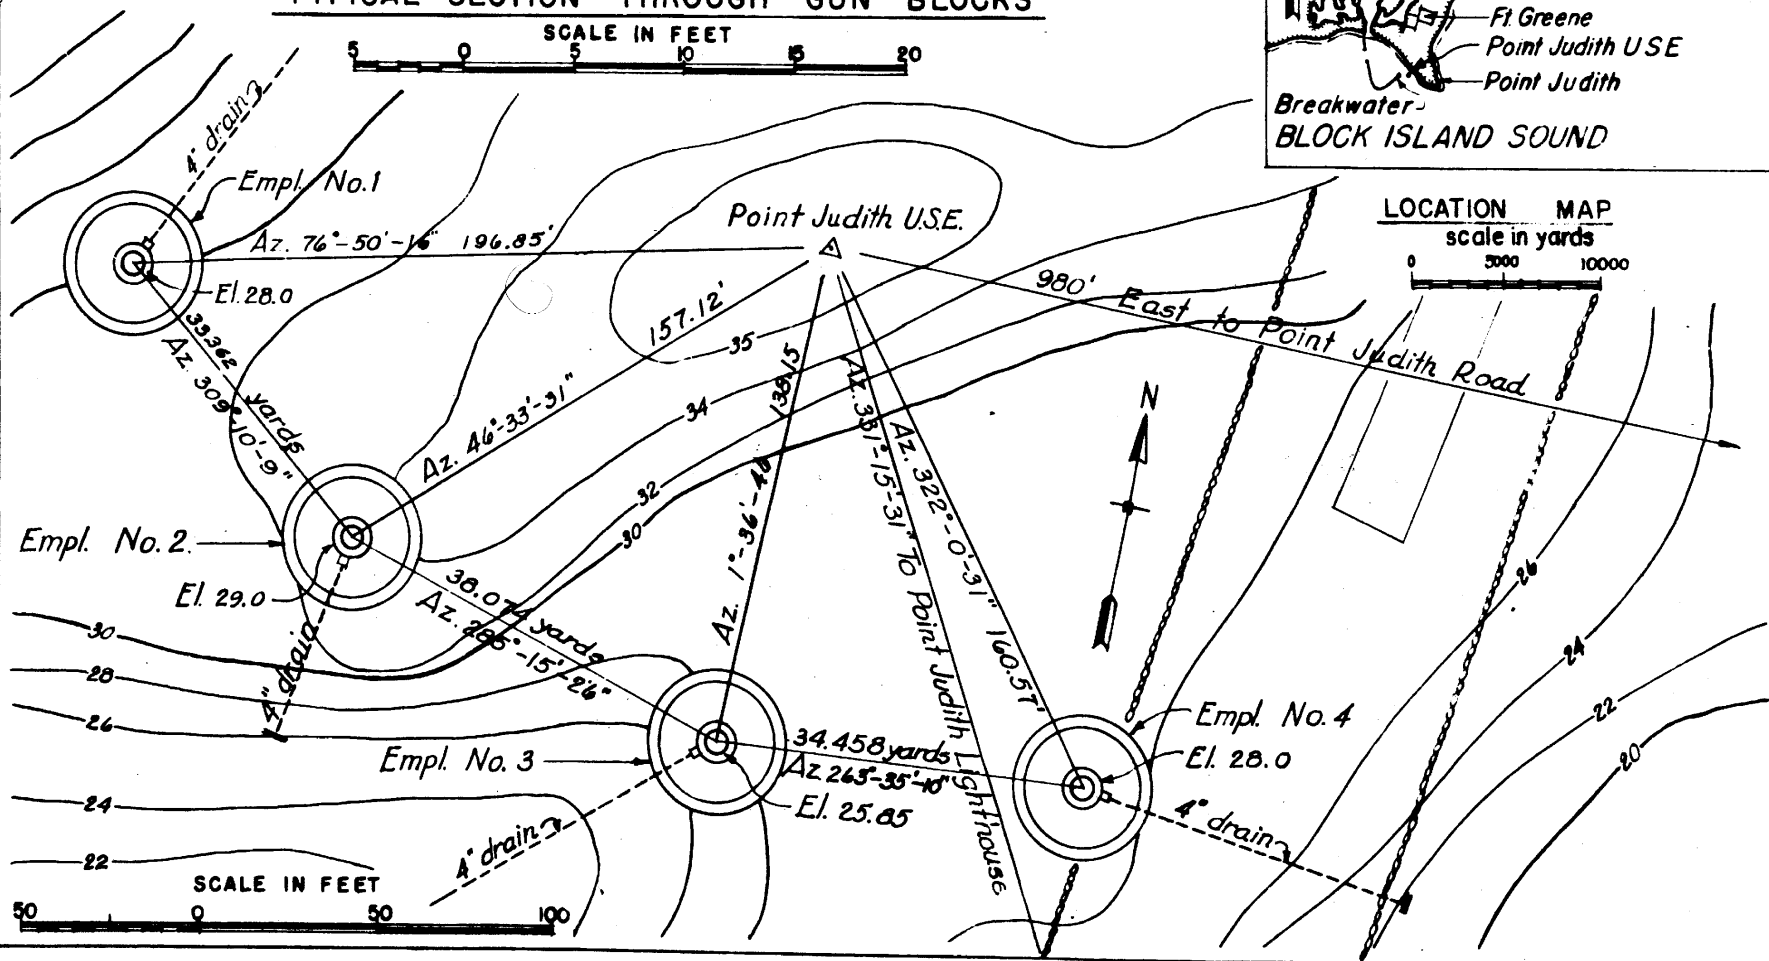


REPORT OF COMPLETED WORKS
BATTERY PLAN

Form 7.

HARBOR DEFENSES OF NARRAGANSETT BAY
FORT CHURCH, R.I.
BATTERY REILLY

No. of guns, 2 — Caliber, 8" Carriage Barbette

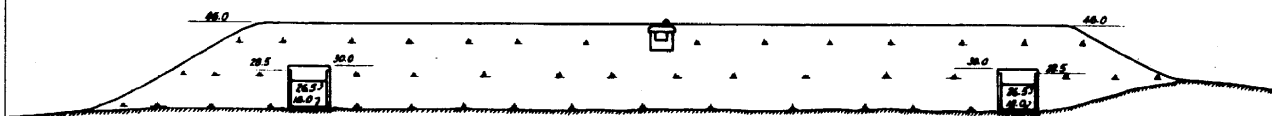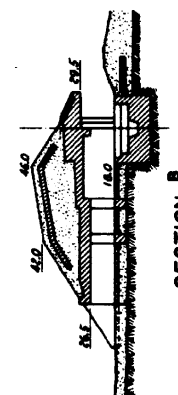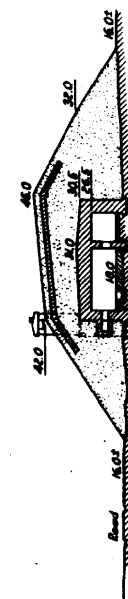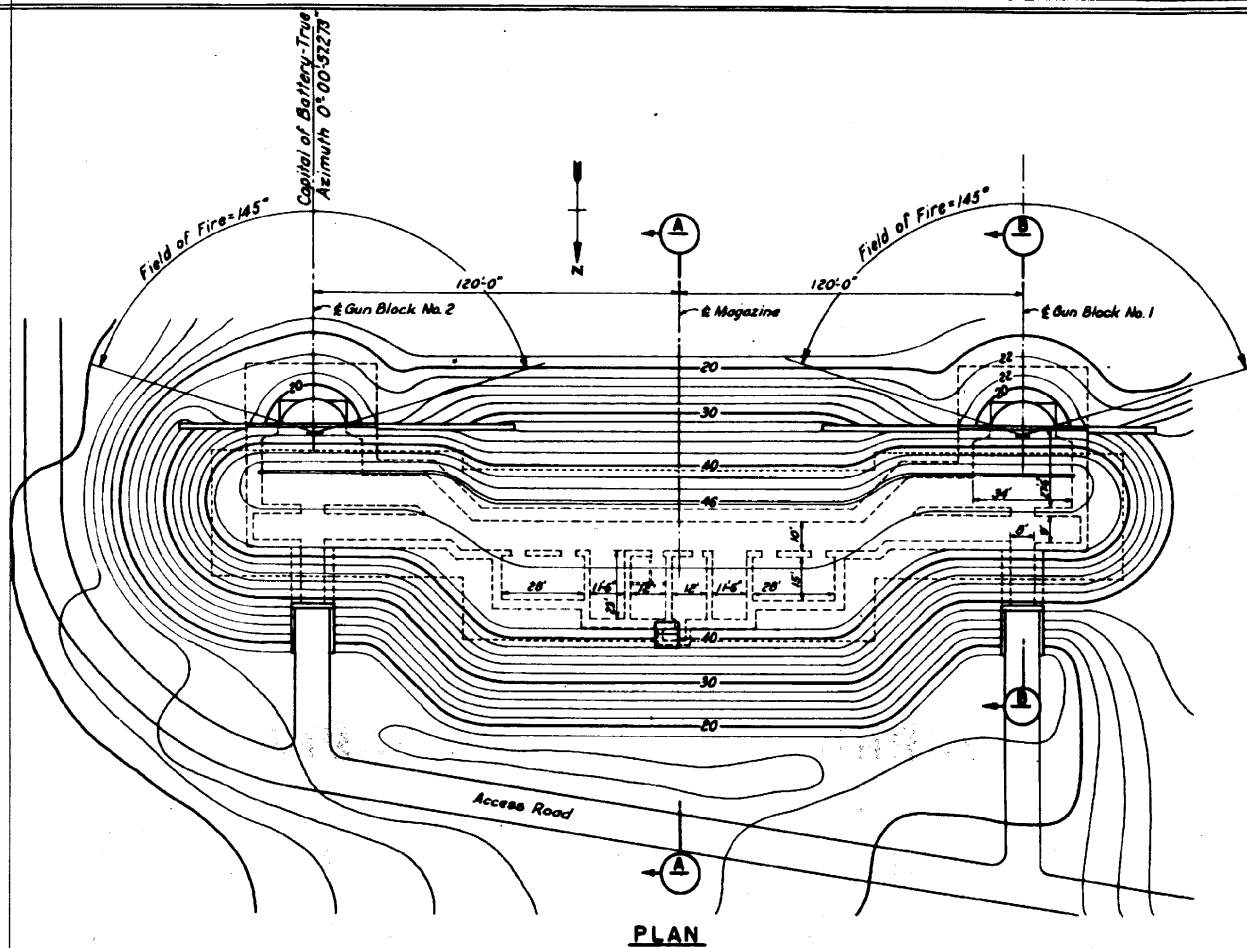


Elevations refer to Mean Low Water Datum.

REPORT OF COMPLETED WORKS- SEACOAST FORTIFICATIONS
(Battery Plan)


FORM NO. 7

CORRECTED TO NOVEMBER, 1942

HARBOR DEFENSES OF NARRAGANSETT BAY
SAKONNET POINT, RHODE ISLAND
BATTERY (155 M.M. PANAMA TYPE EMPLACEMENTS)
NO. OF GUNS- 2. CALIBER- 155 M.M.
CARRIAGE- FIELD PIECE

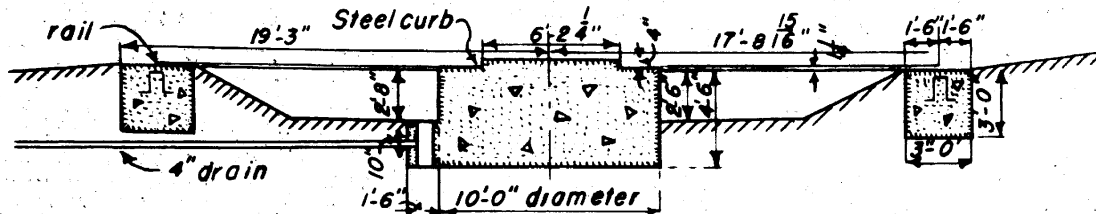


TYPICAL SECTION THROUGH GUN BLOCKS

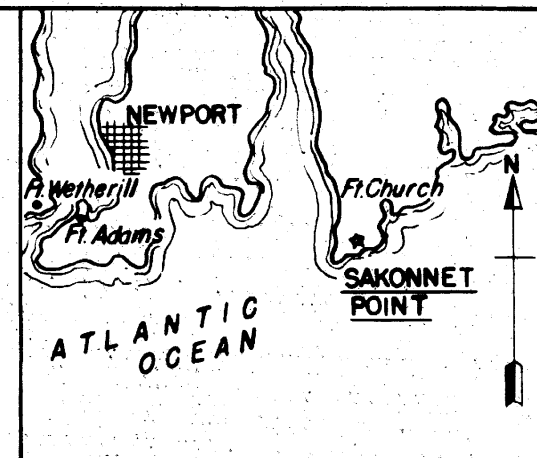

LOCATION MAP

SCALE - 1" = 28,500

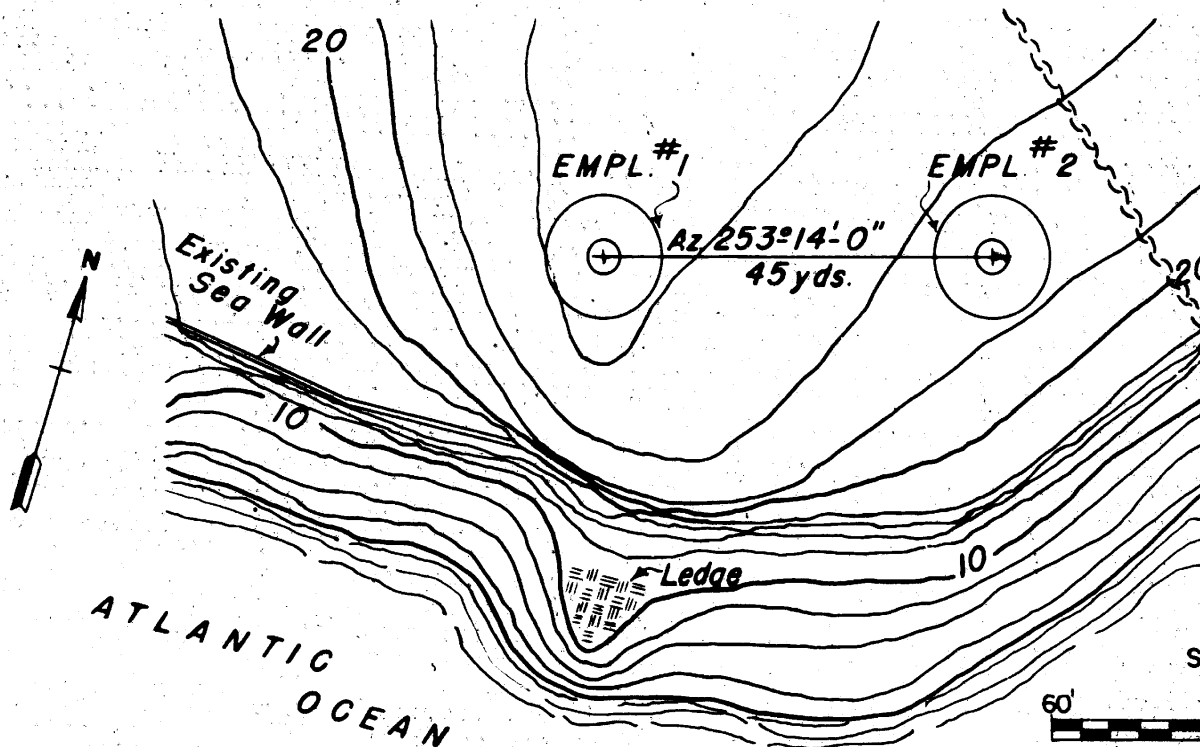

x,y coordinates refer to the
U.S.C. & G.S. (Lambert for Narr. Bay) system.

COORDINATES

EMPL # 1	EMPL # 2
x-126,861.24	x-126,904.46
y-96,255.18	y-96,268.20

SCALE 1" = 60'





REPORT OF COMPLETED WORKS
BATTERY PLAN

FORM 7

CORRECTED TO NOVEMBER 1942

HARBOR DEFENSES OF NARRAGANSETT BAY
BEAVERTAIL POINT, R.I.
BATTERY WHITING


No. of guns, 2 — Caliber, 3" R.F. Carriage, Barbette

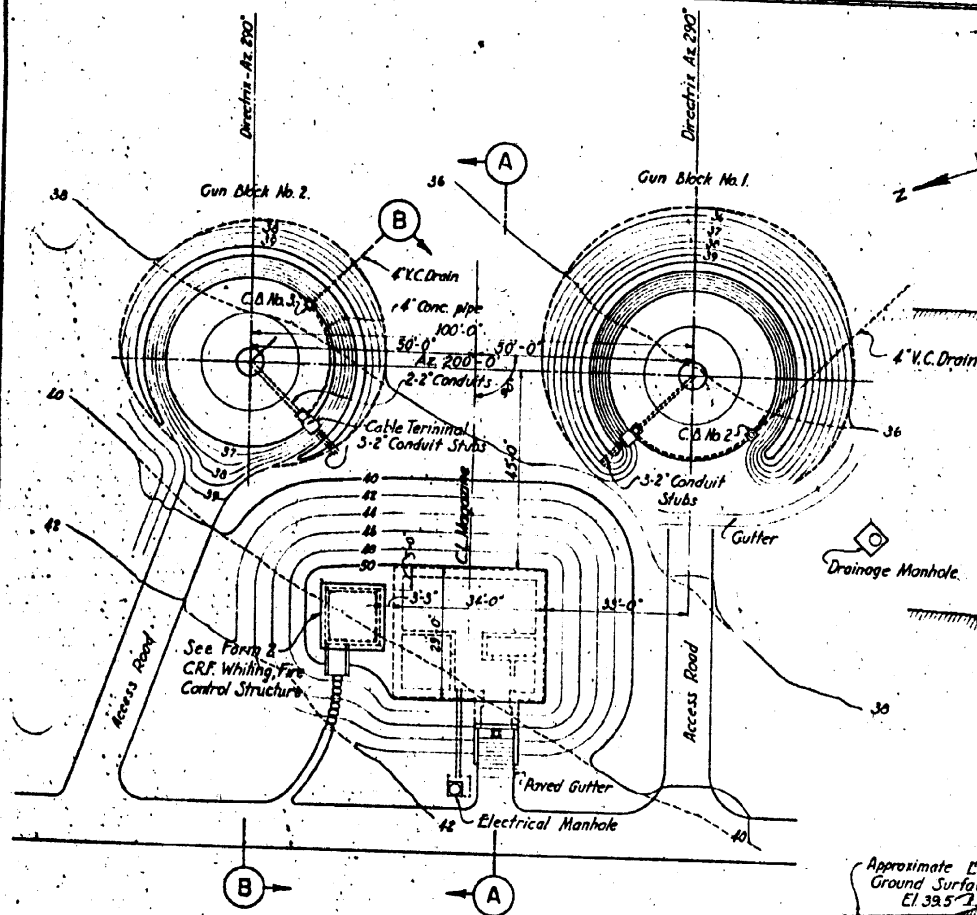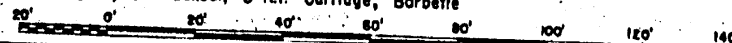


PLAN

See Form 2, C.R.F. Whiting
Fire Control Structure

REAR ELEVATION OF MAGAZINE

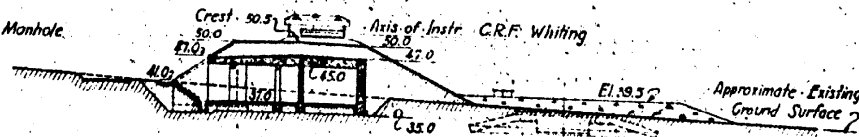

SECTION A.A.

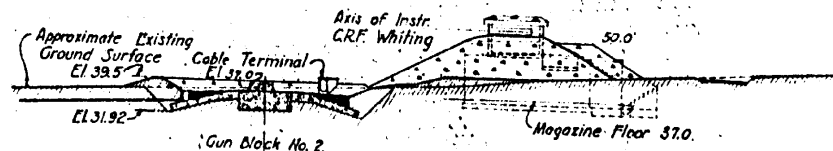

SECTION B.B.

Elevations refer to Mean Low Water Datum